

PLAT AND RECORD

COUNTY BUILDING
CITY OF JANESVILLE


MICROFILMED

Of a Survey on Section 6 T 2 R 14 E. of the 4 P. M. in Bradford Township

Rock County, Wisconsin, made June the 7th & 8th 1887

I hereby certify that the following is a correct record of said survey as made by me.

(Signed) R. Klee Dep. County Surveyor.
R.H.B.

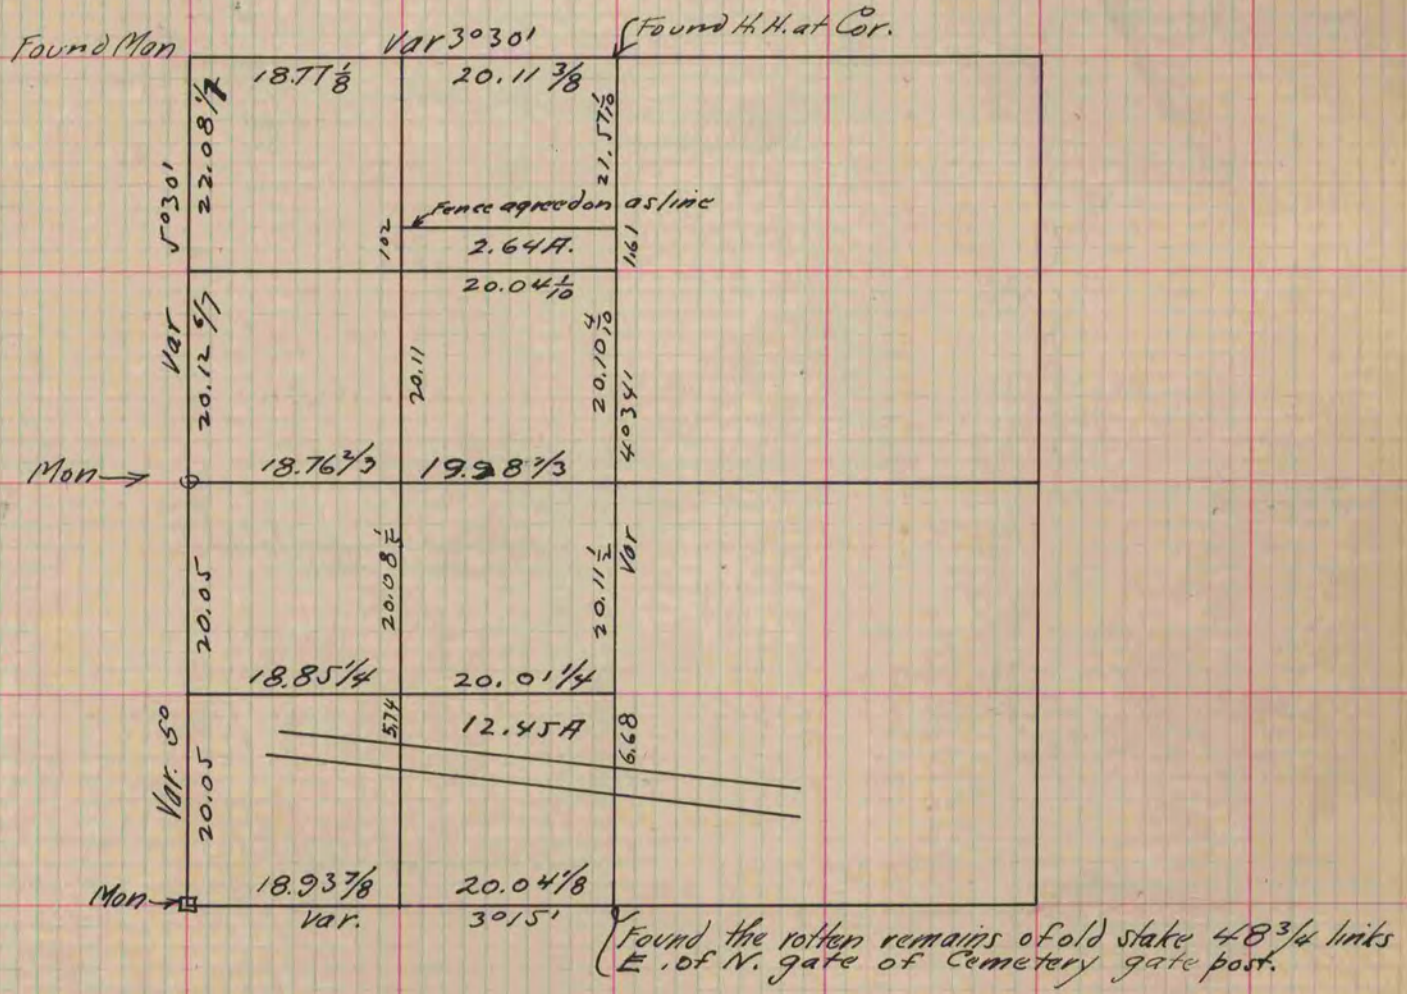

Copied from P. 317 Vol. 2. County Surveyors Record.