

# PLAT AND RECORD

38  
V-2

**MICROFILMED**


Of a Survey on Section 13 T 2 R 11 E. of the 4 P. M. in Plymouth Township  
Rock County, Wisconsin, made June the 11 1870

I hereby certify that the following is a correct record of said survey as made by me.

COUNTY BUILDING  
CITY OF JANESVILLE

(Signed) Edward Ruger  
R.H.B.

Deputy  
County Surveyor.

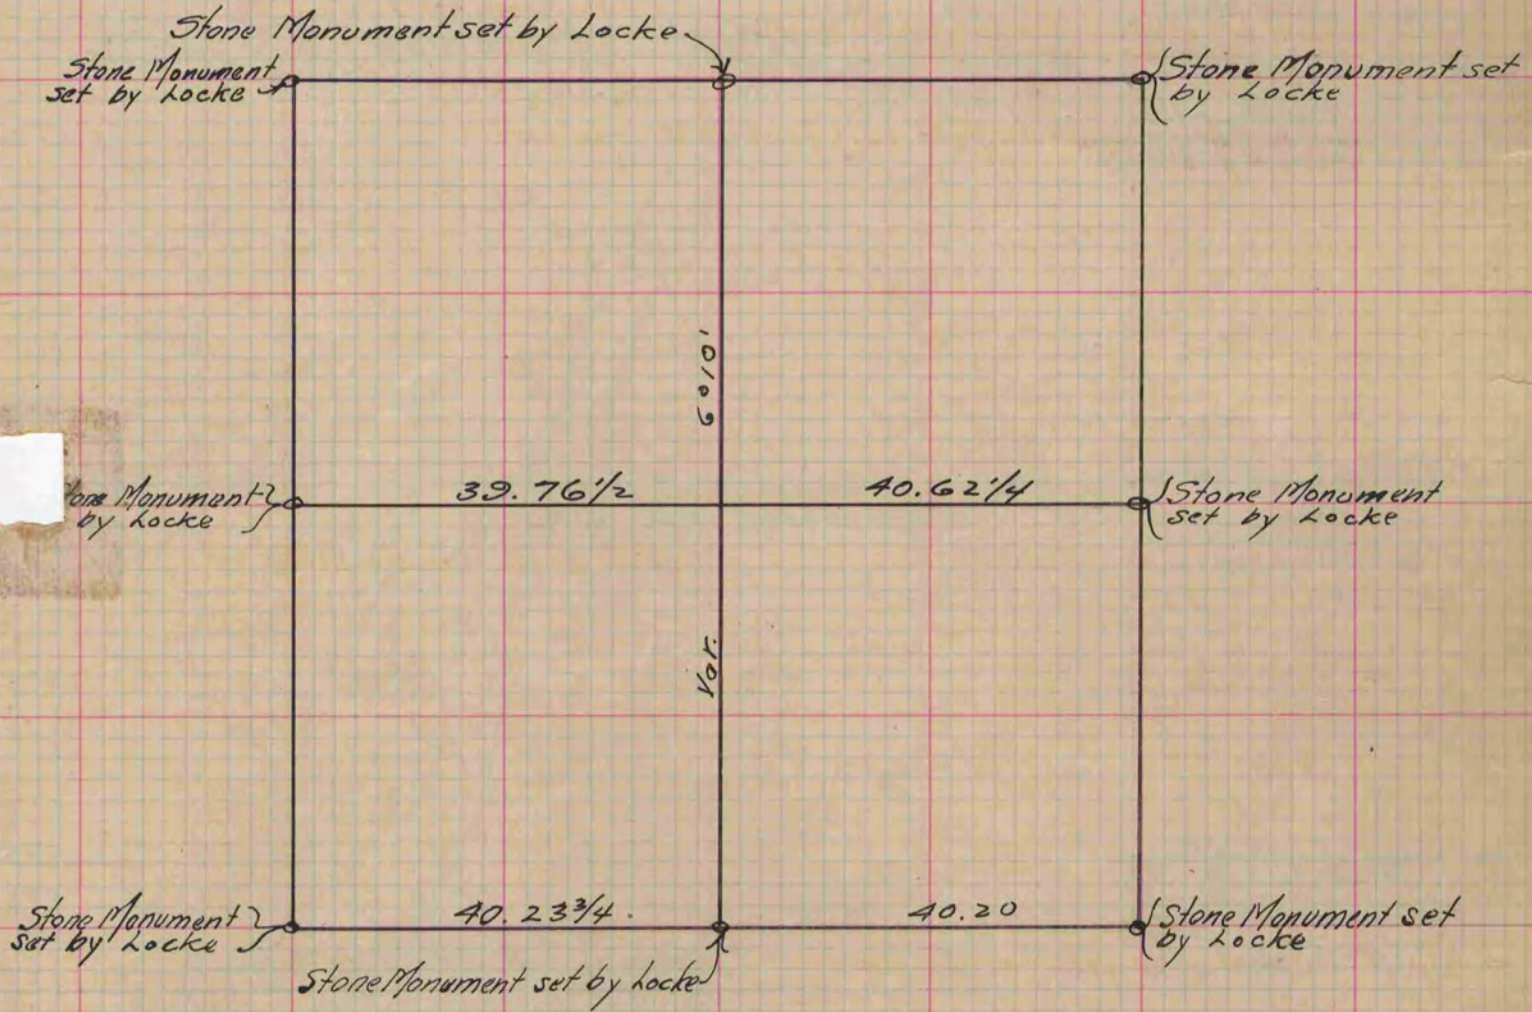

Copied from power  $\frac{1}{2}$  P. 23 Vol. Original County Surveyors Record