

MICROFILMED

PLAT AND RECORD

117
V-3


Of a Survey on Section 9-6 T 3 R 12 E. of the 4 P. M. in JANESVILLE Township

Rock County, Wisconsin, made Aug 17 the _____ 19____

I hereby certify that the following is a correct record of said survey as made by me.

COUNTY BUILDING
CITY OF JANESVILLE

County Surveyor.

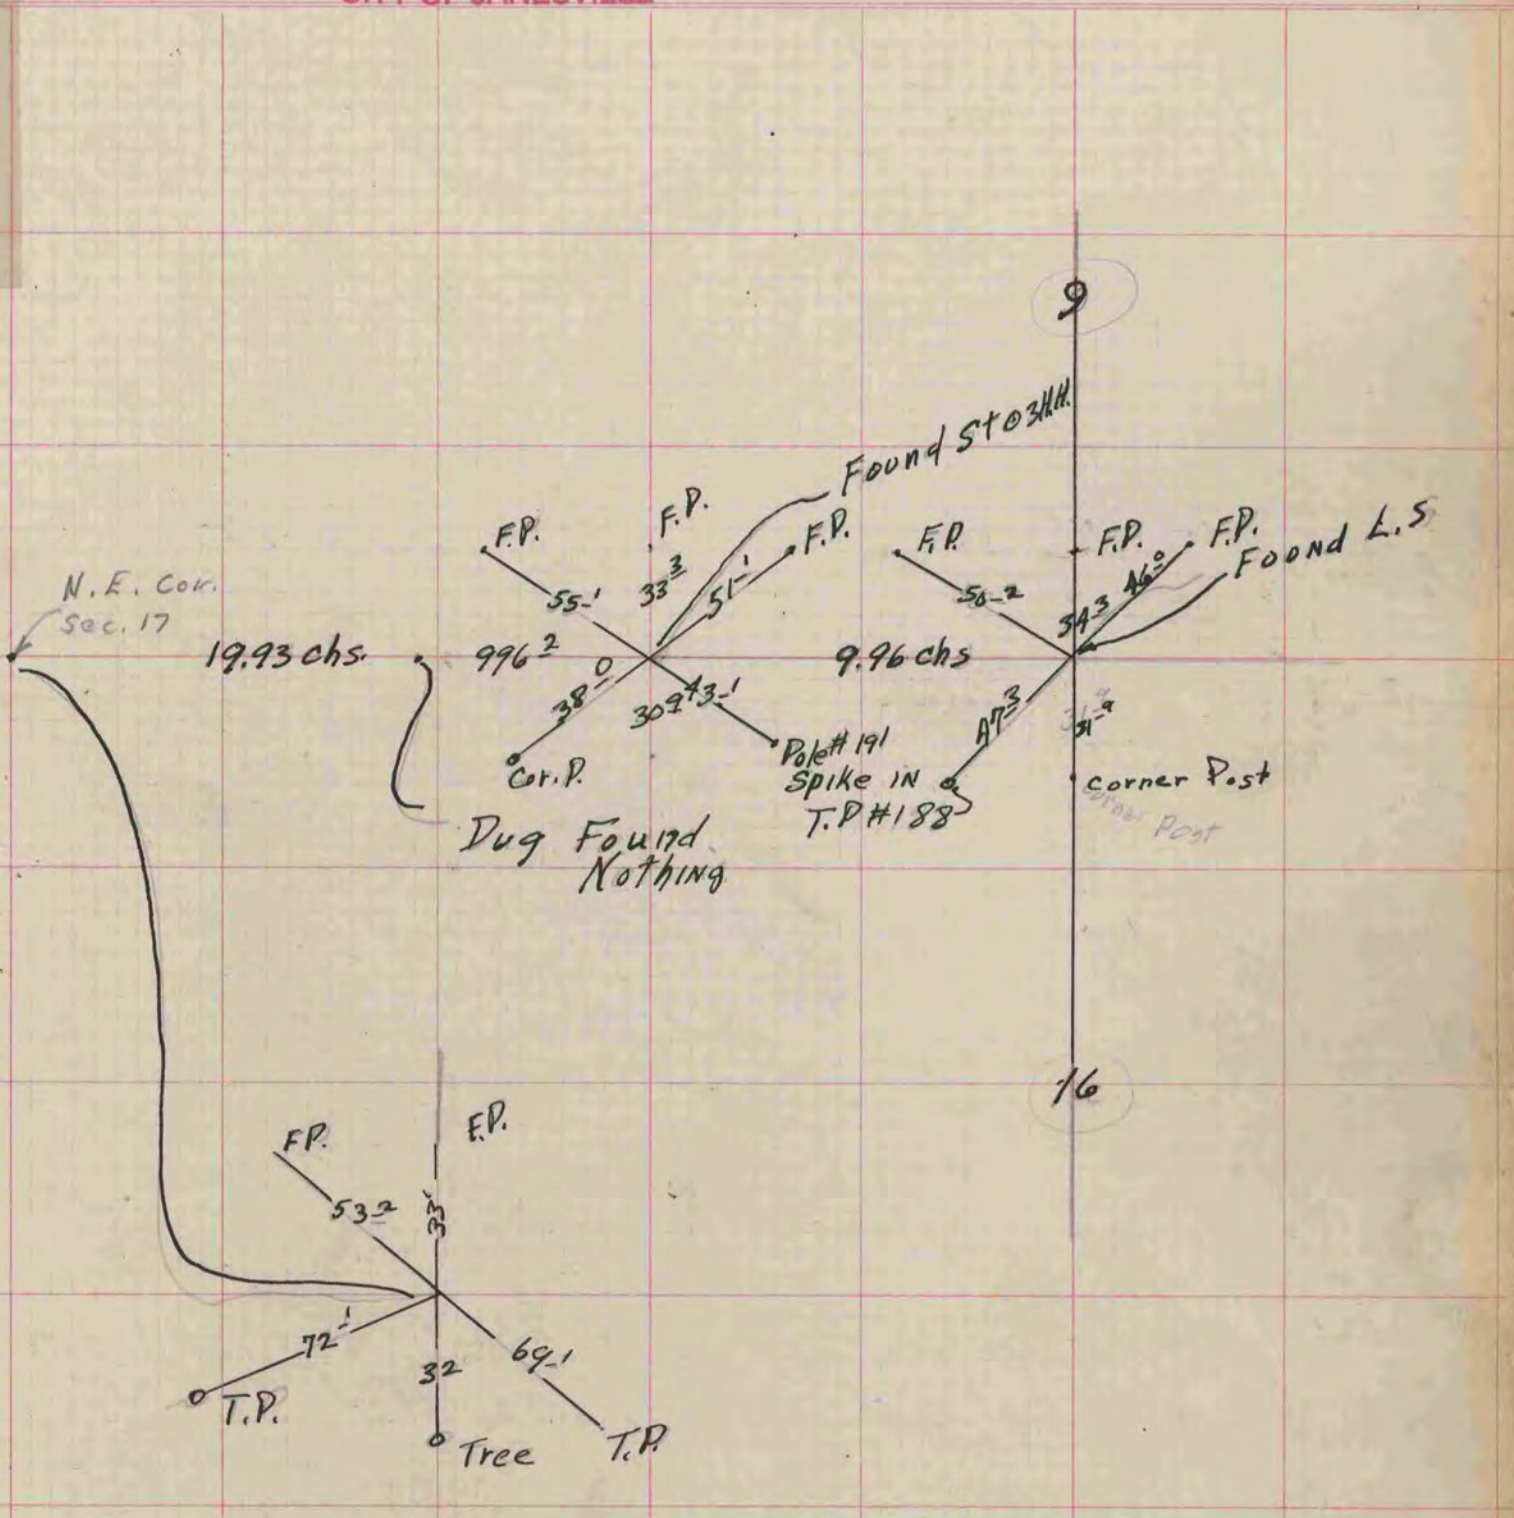

Mon was also dug for in Sec. 32. Porter
and Sec 2 Center