


318
 V-**MICROFILMED** PLAT AND RECORD

Of a Survey on Section 27 T 3 R 13 E. of the 4 P. M. in Harmony Township
 Rock County, Wisconsin, made April the 17 1868

I hereby certify that the following is a correct record of said survey as made by me.

COUNTY BUILDING
 CITY OF JANESVILLE

(Signed) S. D. Locke
 R.H.B. County Surveyor.

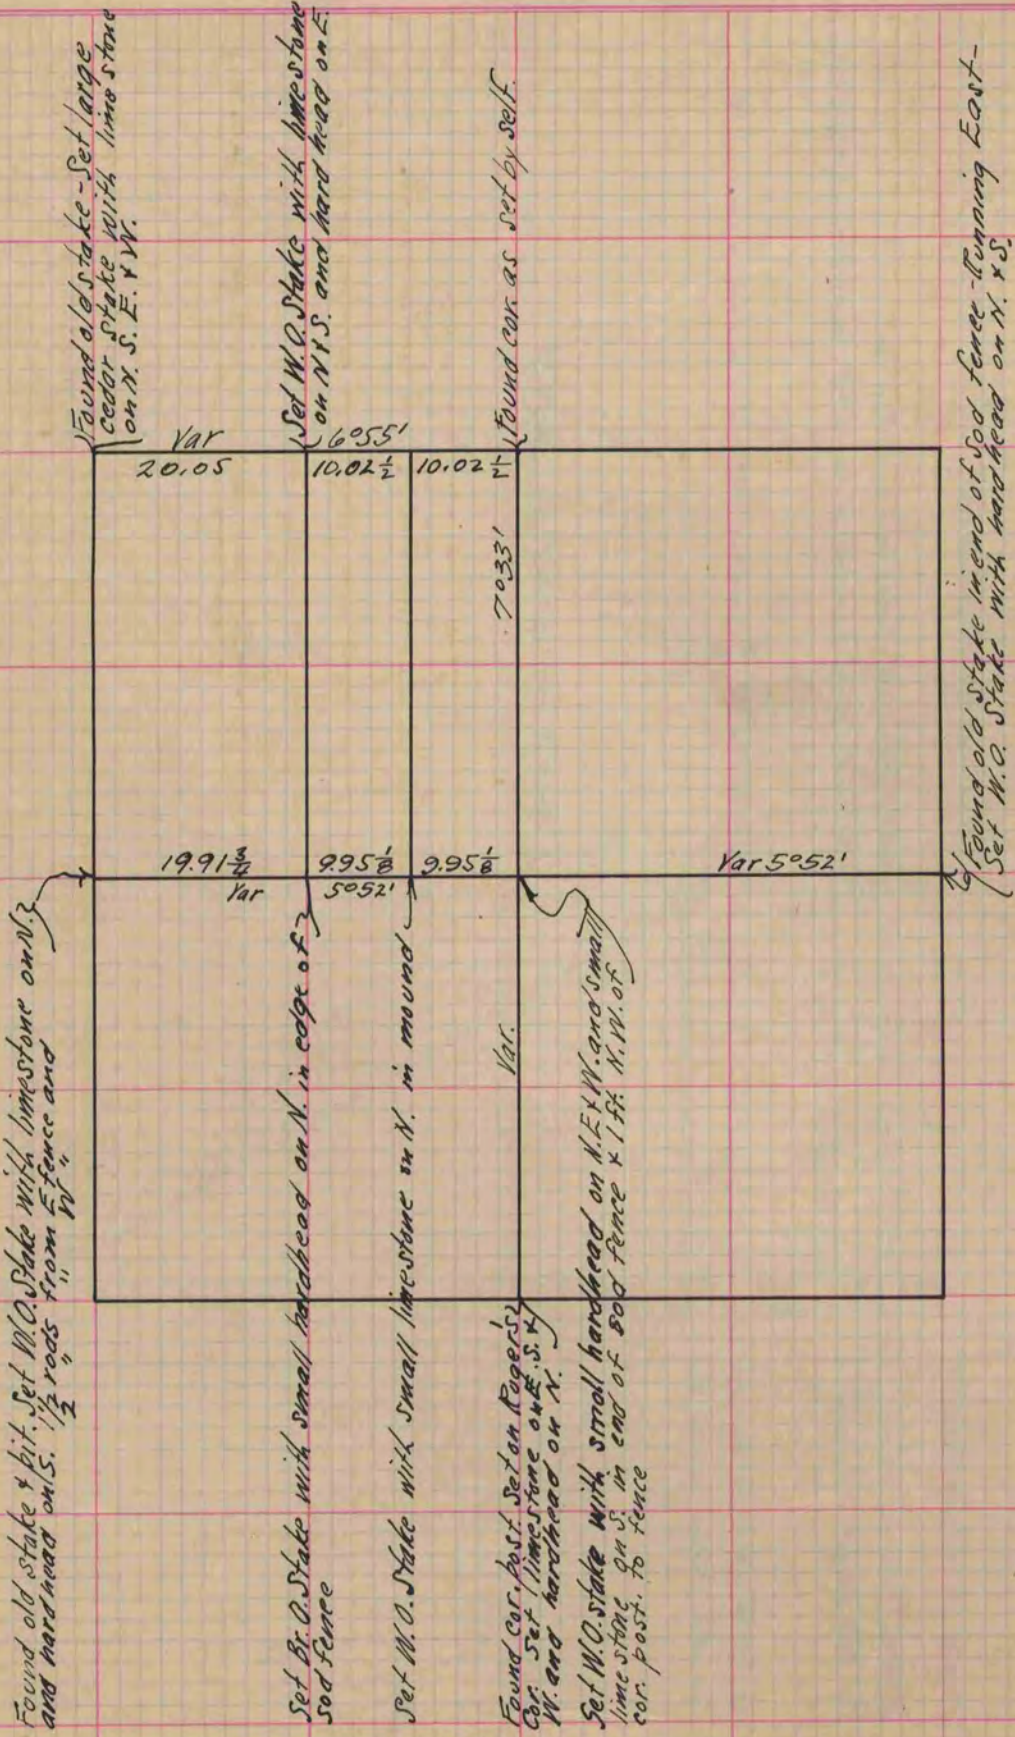

Copied from Page 265 Vol. 1. Original County Surveyors Record