


MICROFILMED PLAT AND RECORD

Of a Survey on ^{the N.W. 1/4} Section 17 T 3 R 10 E. of the 4 P. M. in Magnolia Township
Rock County, Wisconsin, made December the 21st 1855

I hereby certify that the following is a correct record of said survey as made by me.

COUNTY BUILDING
CITY OF JANESVILLE

(Signed) Joseph Church
S.H.B. County Surveyor.

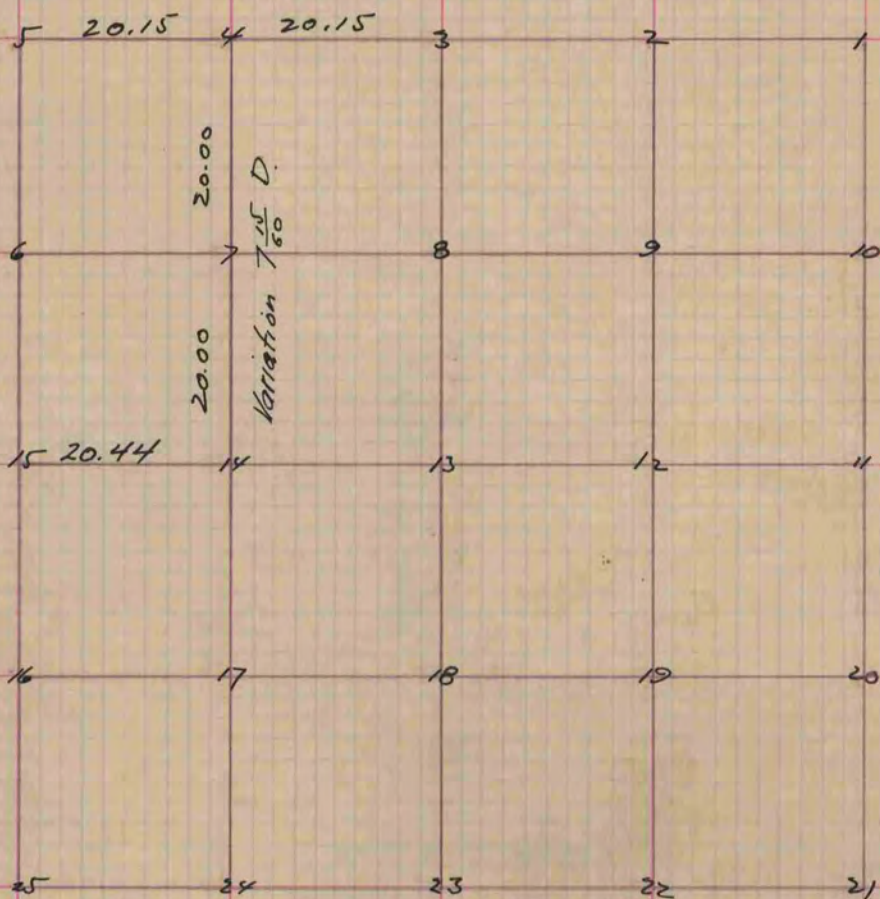

From Fig 15 to 11 overruns 177^c found stake by stumps marked
 Fig 14 Buried Stone
 7 Bur 0 20⁰ 57 1/2 W 55
 Br. 0 18 S 21 E 69
 4 W. 0. 20 N. 63 W 30
 W. 0. 24 N 73 E 60

Fig 6. see preceding page marked Fig. 10
 Copied from Page 57 Vol. 1. Original County Surveyors Record