

Of a Survey on Section 22 T 3N R 11 E. of the 4 P. M. in CENTER Township
Rock County, Wisconsin, made DECEMBER the 27 1968

I hereby certify that the following is a correct record of said survey as made by me.

MICROFILMED

R. B. Batteman Jr


County Surveyor.

FD. STAKE @ H.H.'s
SET 2" PIPE

FD. STAKE @ 3 H.H.'s
SET 1" PIPE

FD. H.H.
SET 1" PIPE

* RESET CAST IRON
MON IN PLACE OF PIPES
* COPIED FROM BELoit REC
12/11/75 DAB

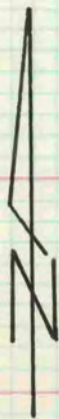

FD. L.S. 3x6x2
@ 4 H.H.'s

FD. L.S.
REFERENCED
WITH SPIKES
3' W. & 3' S.

2-2

SET 1"
PIPE

PIPE (not referenced)

FOUND

REFERENCED
SEE VOL. 4
P. 354

WORK DONE BY C. SHIMEALL