

# PLAT AND RECORD


COUNTY BUILDING  
CITY OF JANESVILLE

443  
VOL. 5

Of a Survey on Section **34** T **4** R **12** E. of the 4 P. M. in **FULTON** Township

Rock County, Wisconsin, made **JUNE** the **23** 1978

I hereby certify that the following is a correct record of said survey as made by me.

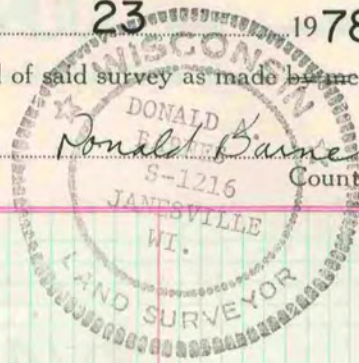

THE GEN. S. BARNARD COMPANY, ST. LOUIS

**N1/4 COR**

FOUND CAST IRON MON 7' SOUTH OF FENCE

7290.38 N/S  
2329.67 E/W

CALCULATED 2652.83  
RUGER (1877) 2657.16

4637.552 N/S  
2326.689 E/W

**CENTER** CALCULATED 2673.53

1/16 COR

4672.08 N/S  
5000.00 E/W

**E1/4 COR**

**W1/4 COR**

4603.51 N/S  
-310.36 E/W  
RUGER (1877) 2638.02  
CALCULATED 2637.26  
FOUND ALUM MON

CALCULATED 2648.25

2030.42 N/S  
-278.75 E/W  
NUMBERS WRONG

**SW COR**

FOUND STONE  
RUGER (1875) 2983.8  
CALCULATED 1302.11

CALCULATED 2643.98

1976.54  
1022.62

**S1/16 COR**

FD 2" IP  
RUGER (1870) 1298.38  
SUNNY (1958) 1302  
CALCULATED 1301.19

**S1/4 COR**

SUNNY (1957) 1559.42  
RUGER (1878) 1558.89  
EDM

FD 2" IP

RUGER (1875) 2682.90  
CALCULATED 2676.12

**SE COR**

CALCULATED 2643.49

2028.59 N/S  
4999.58 E/W

GLEN NORTHRUP SUPPLIED THE ABOVE DATA.

COORDINATES ARE BASED ON AN ARBITRARY BASE

MICROFILMED