

PLAT AND RECORD




543
VOL. 5

Of a Survey on Section 4 T 3 R 14 E. of the 4 P. M. in JOHNSTOWN Township
Rock County, Wisconsin, made JUNE the 12 1979

I hereby certify that the following is a correct record of said survey as made by me.

COUNTY BUILDING
CITY OF JANESVILLE

Donald Barnes
County Surveyor.

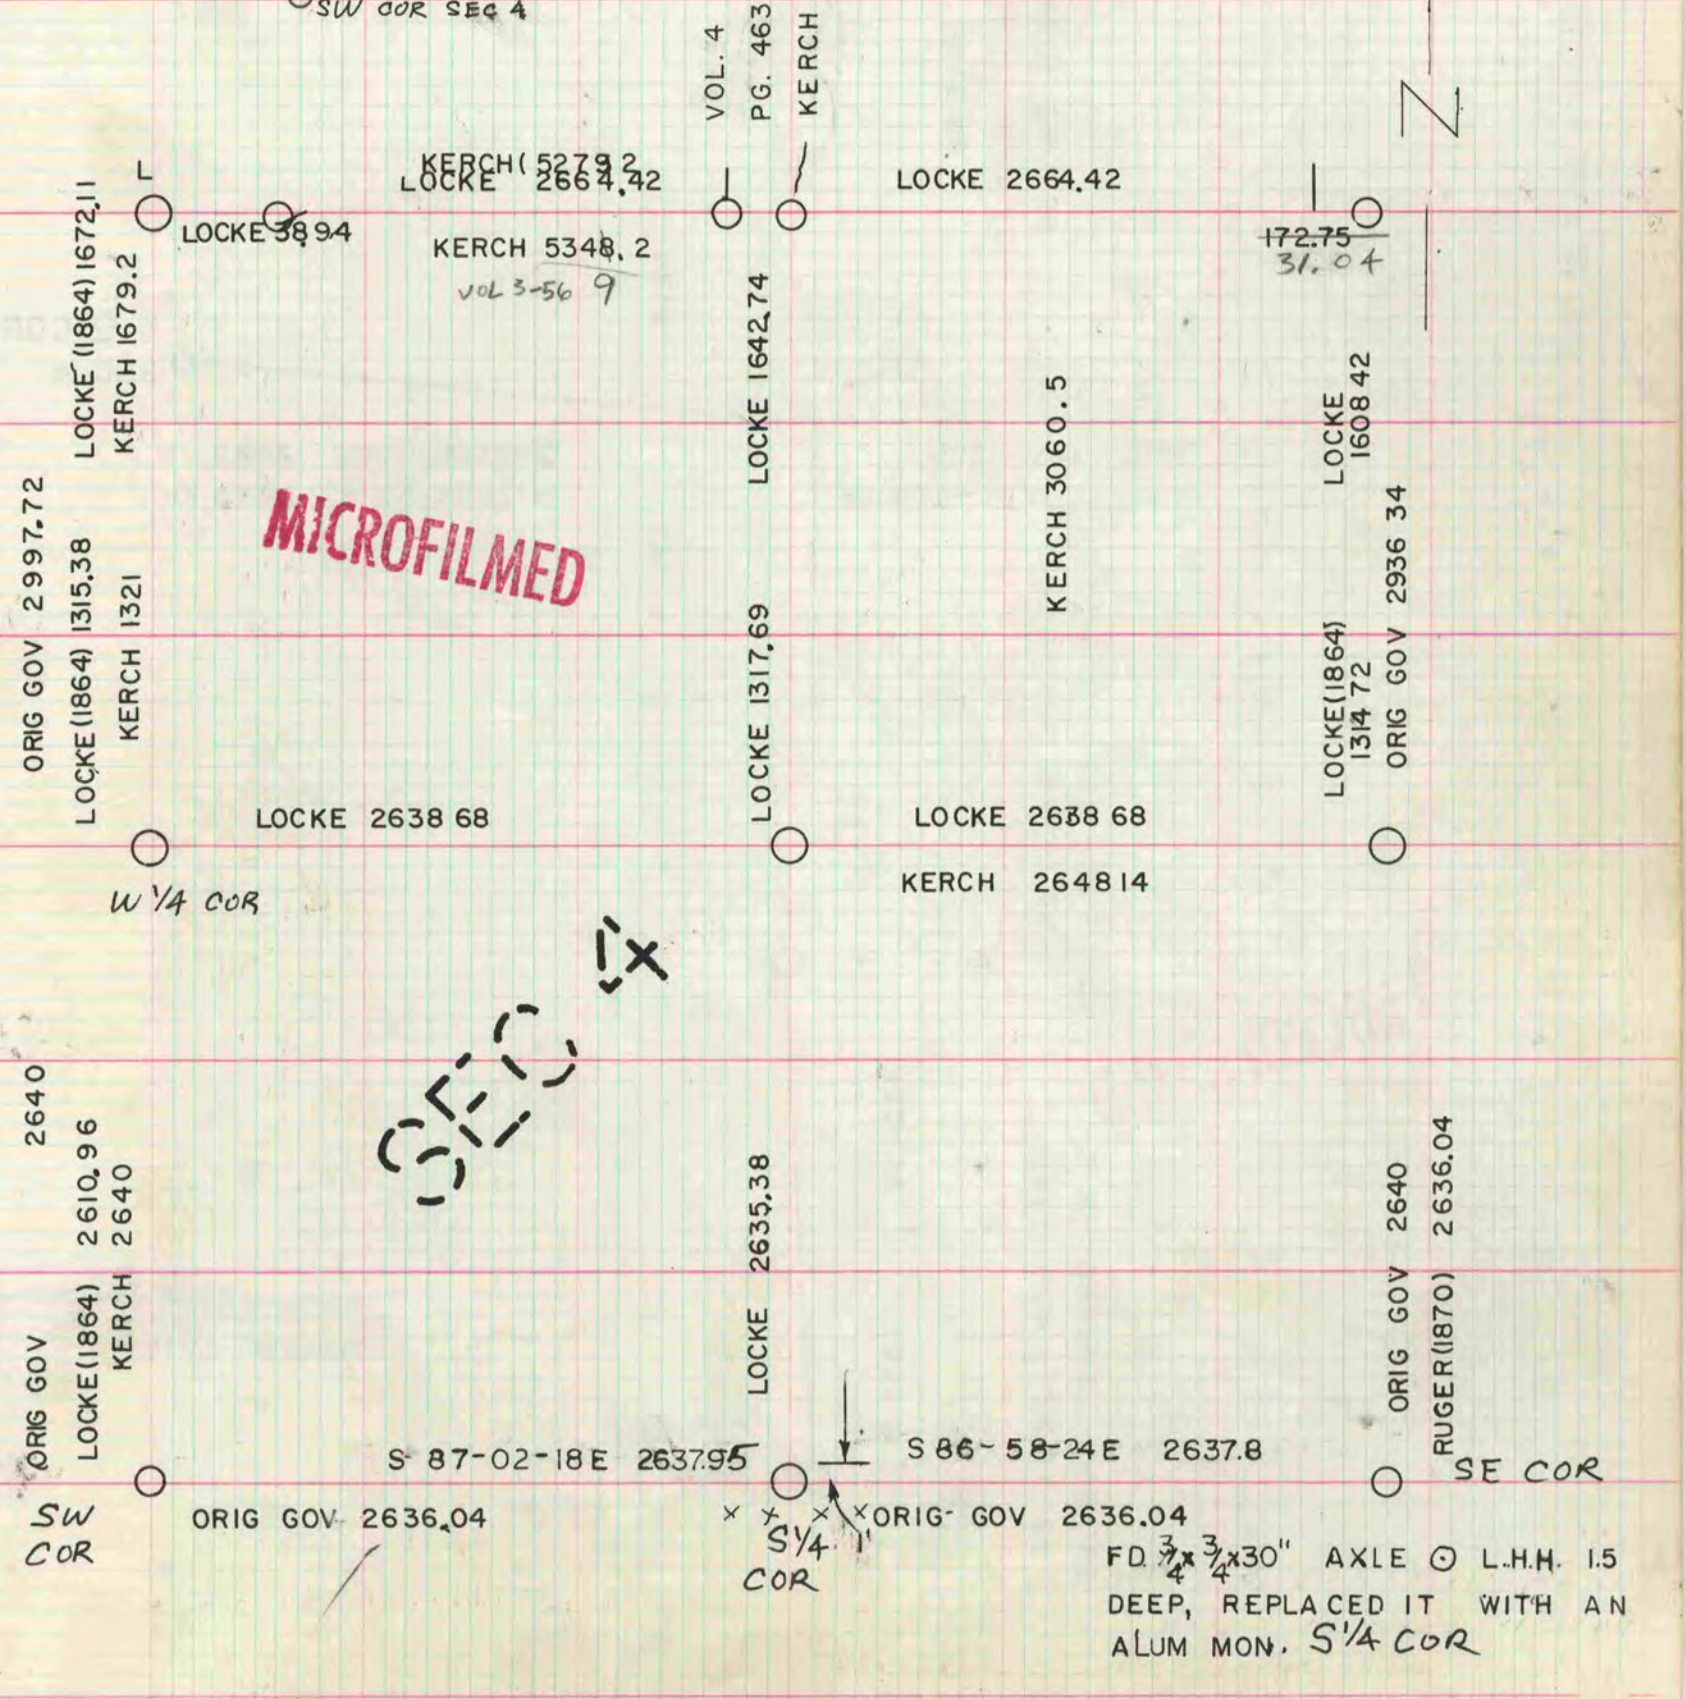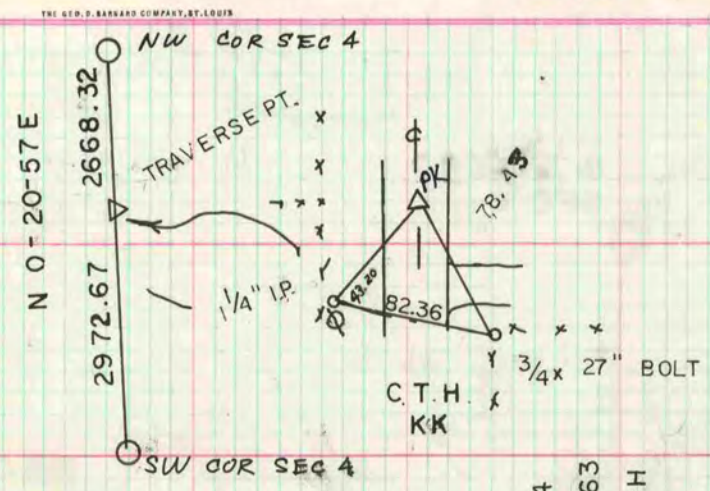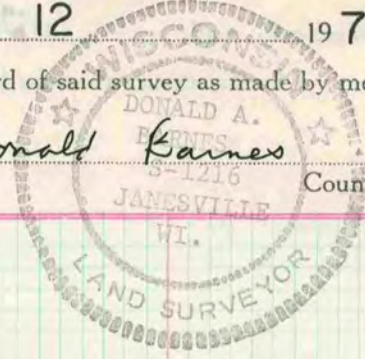

MICROFILMED

SEC 4