

PLAT AND RECORD

COUNTY BUILDING
CITY OF JANESVILLE

9, 10
Of a Survey on Section 15, 16 T 1 R 13 E. of the 4 P. M. in TURTLE Township


Rock County, Wisconsin, made Nov the

I hereby certify that the following is a correct record of said survey as made by me.



Donald Barnes
County Surveyor.

S89°26'13"E 1329.21

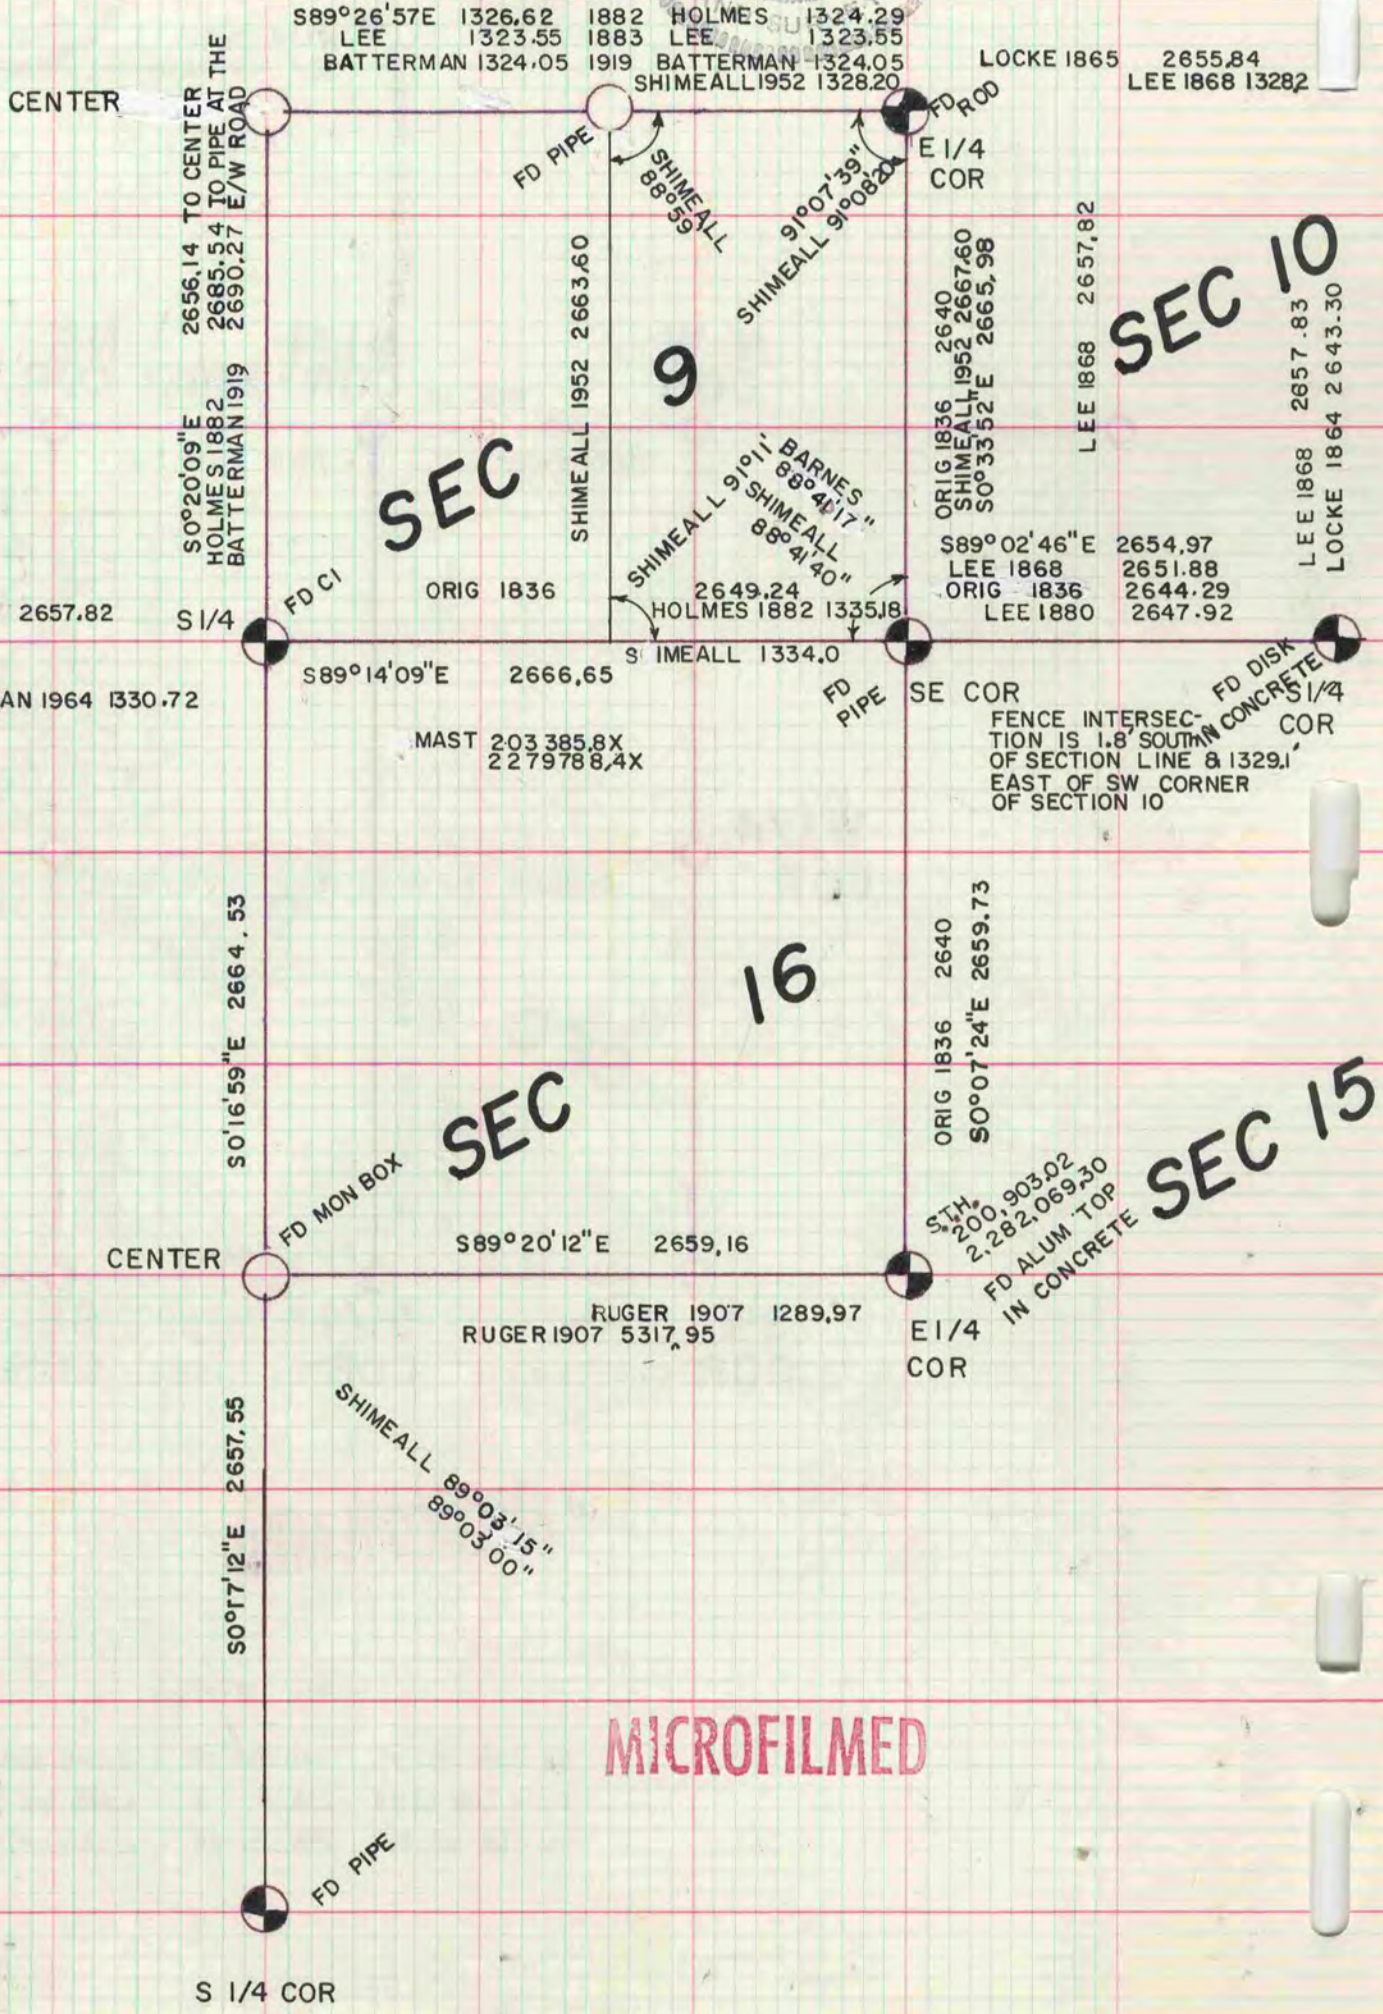

SEC 9

SEC 10

SEC 16

SEC 15

MICROFILMED