

PLAT AND RECORD



359
VOL. 6

Of a Survey on Section **6** T. **2** R. **13** E. of the 4 P. M. in **LA PRAIRIE** Township
Rock County, Wisconsin, made **APRIL** the **25** 19**86**


I hereby certify that the following is a correct record of said survey as made by me

**COUNTY BUILDING
CITY OF JANESVILLE**

Donald Barnes

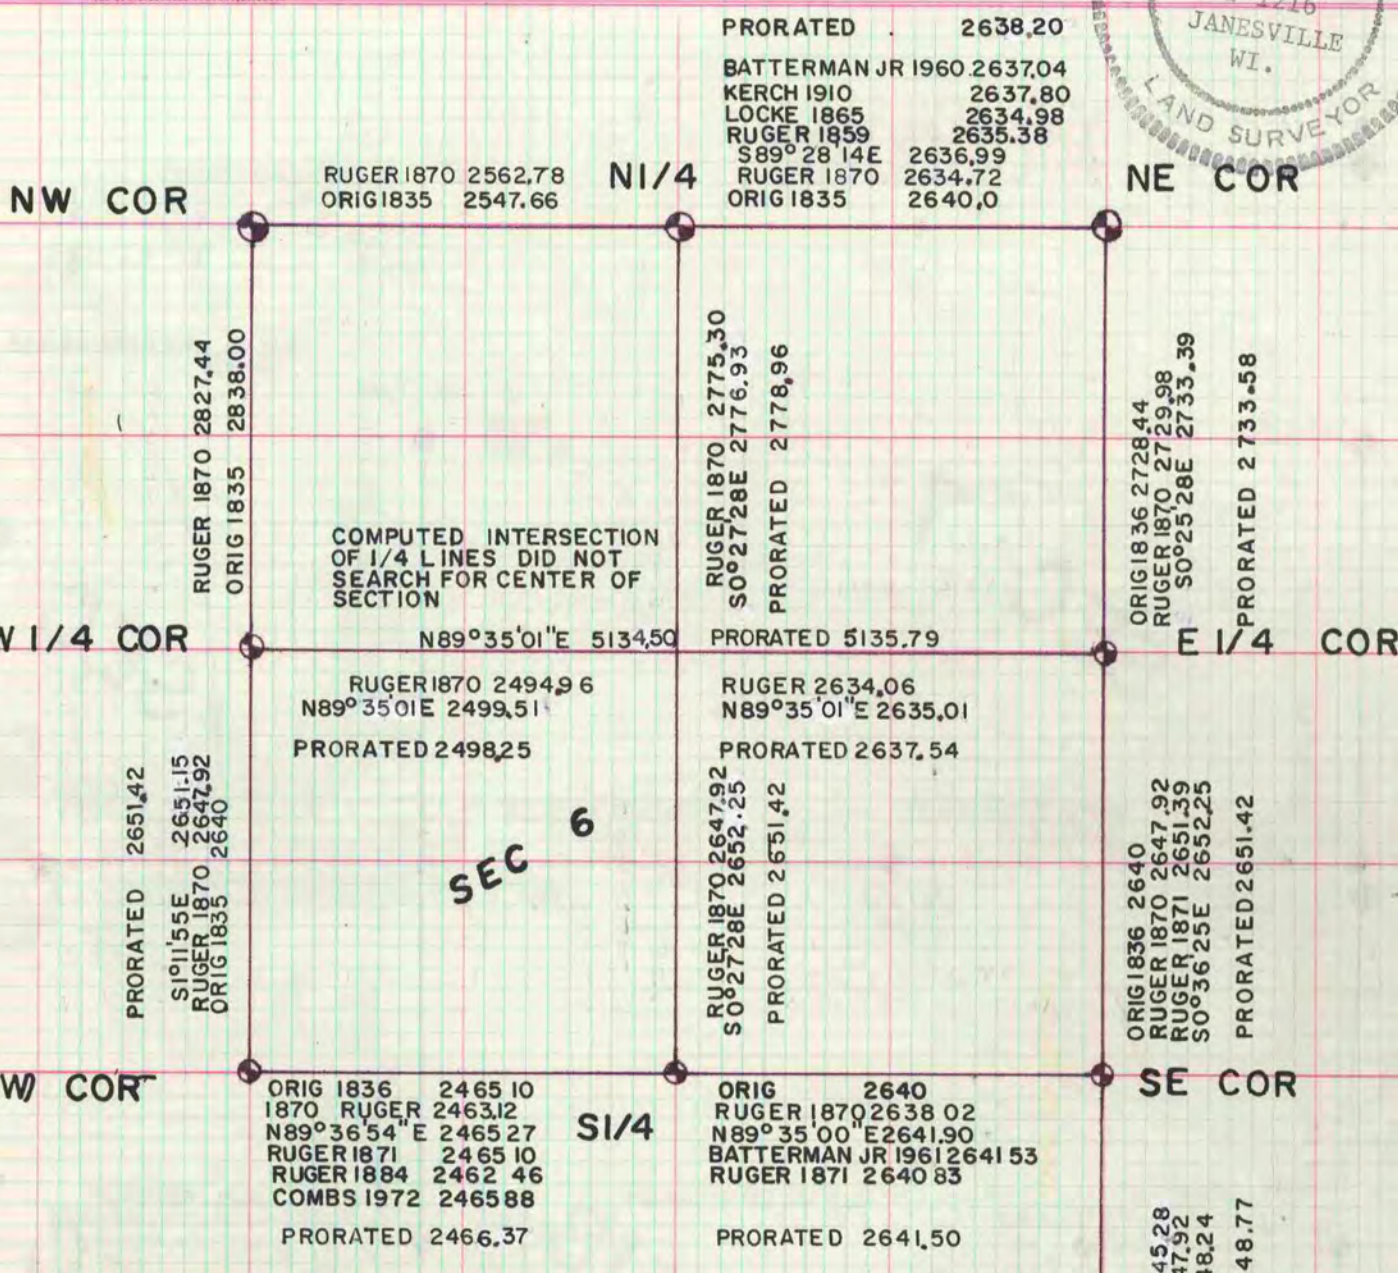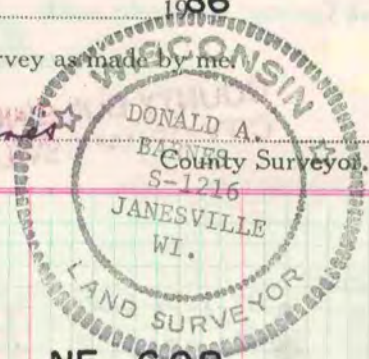

THE PRORATED DISTANCES ARE COMPUTED FROM THE SUM OF THE FIELD MEASURED DISTANCES & RUGER'S 1870 MEASUREMENTS BETWEEN ALL THE CORNERS THAT WERE MEASURED TO PRIOR TO ESTABLISHING THE WEST QUARTER CORNER

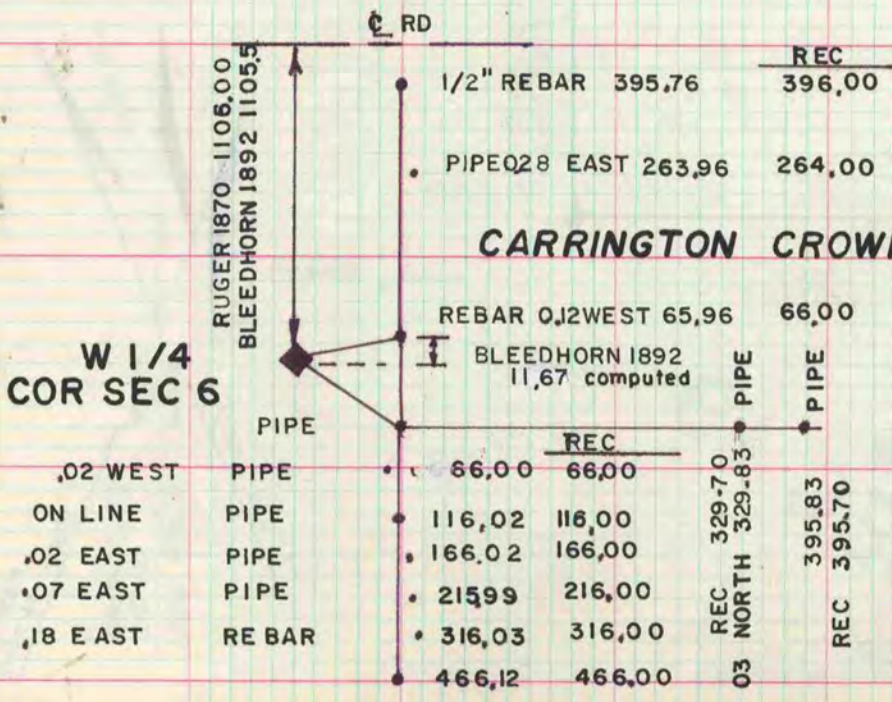

CARRINGTON CROWN ADDITION VOL 5 PG 29

MICROFILMED

SHIELDS VOL 10 PG 12

1985 TWP PROJECT