

PLAT AND RECORD

135

VOL. 6

Of a Survey on Section **3, 13** T. **1** R. **10** E. of the 4th P.M. in **AVON** Township
Rock County, Wisconsin, made **FEBRUARY 26** 19**81**

I hereby certify that the following **DONALD** of said survey as made by me.
COUNTY BUILDING CITY OF JANESVILLE




County Surveyor.

E 1/4 COR SEC 3

FD PK AS USED IN 1980 REPLACED WITH ALUM MON


SE COR SEC 3

MICROFILMED

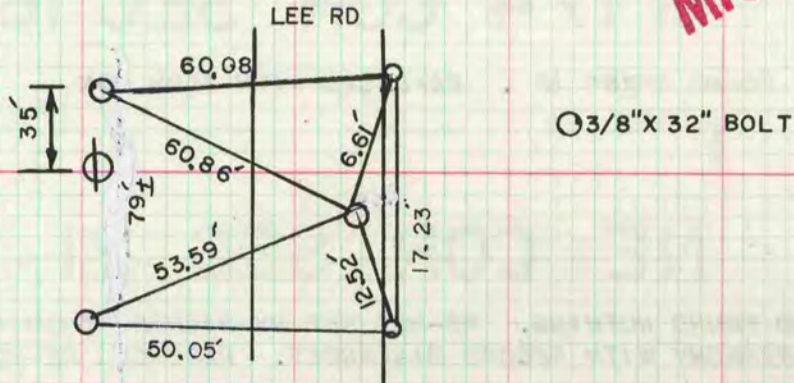

S 1/4 COR SEC 13

FD R R SPIKE & UNDER ^{THE} FD NAIL. REPLACED WITH ALUM MON

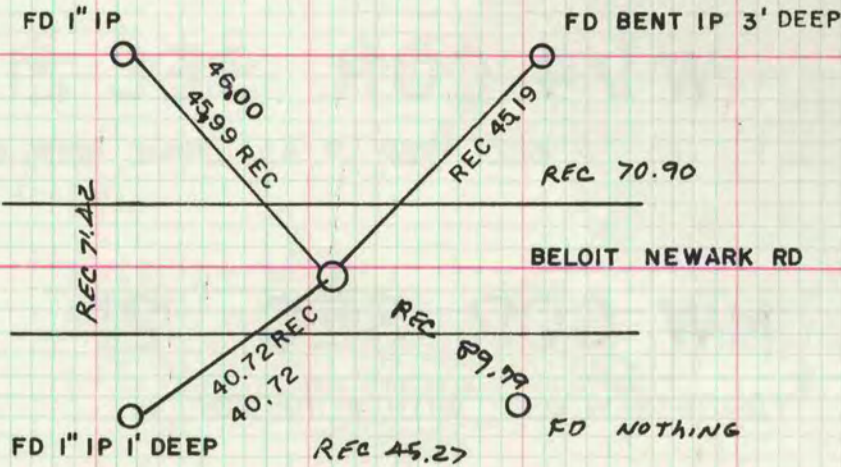

SE COR SEC 13

FD TIES SET R R SPIKE (3 SOUTH OF $\frac{1}{2}$ RD & ON TOP OF ^{CMP} GSM)

