

PLAT AND RECORD

VOL. 6 ~~581~~
35


Of a Survey on Section 3 T 2 R 14 E. of the 4 P. M. in BRADFORD Township
Rock County, Wisconsin, made MAY 80

I hereby certify that the following is a correct record of said survey as made by me.

COUNTY BUILDING
CITY OF JANESVILLE



SE COR SEC 3

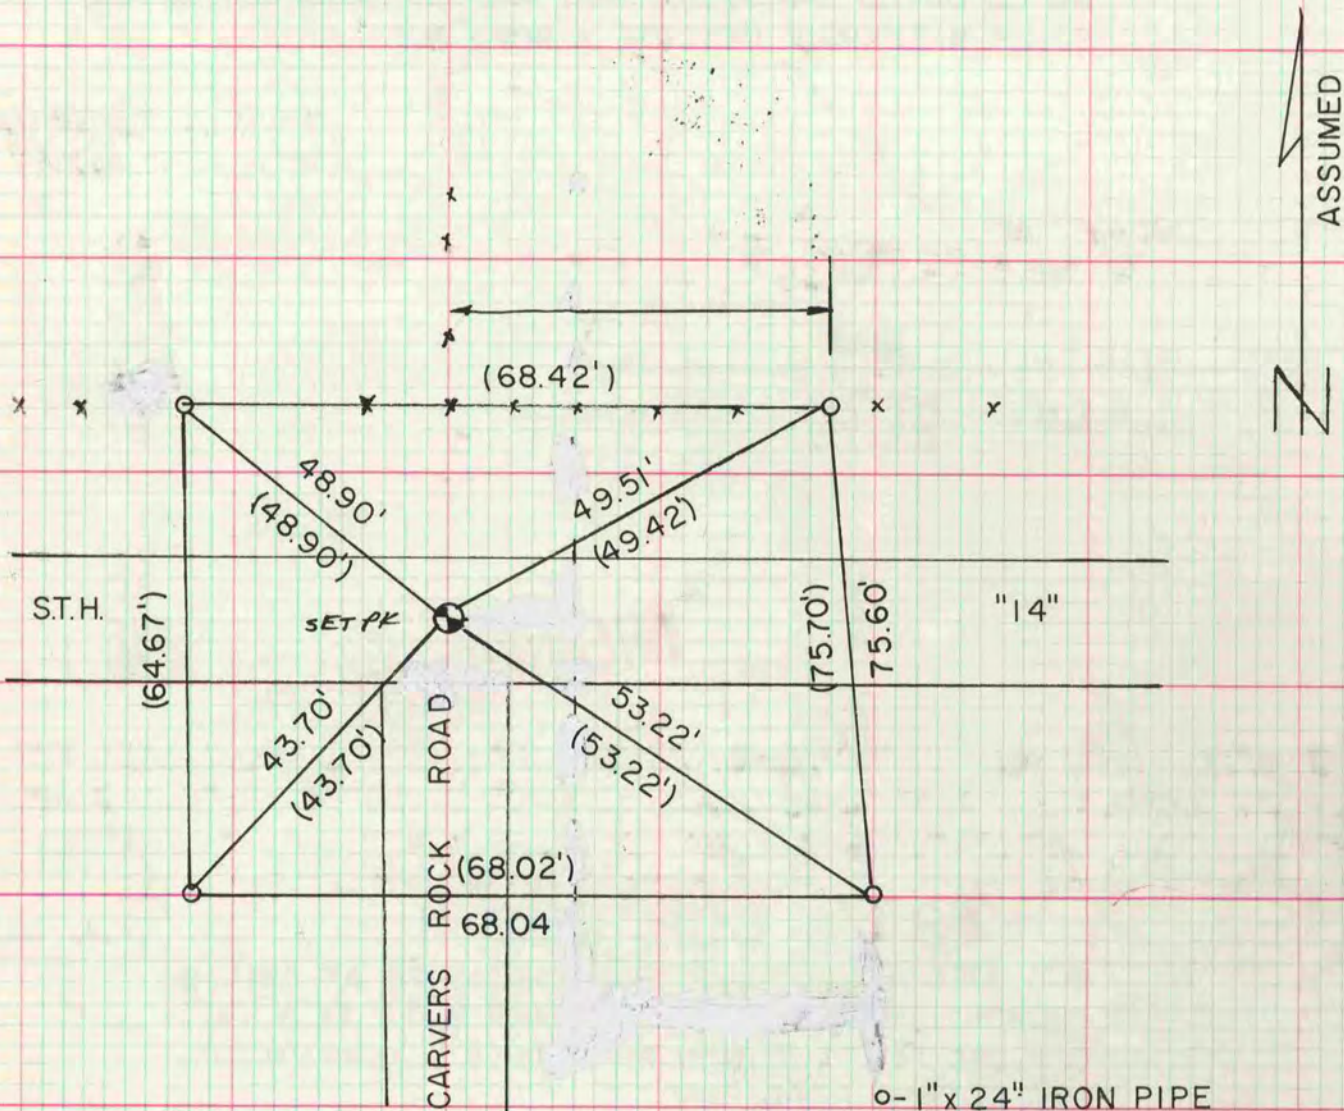

o-1" x 24" IRON PIPE
()-PREVIOUSLY RECORDED
VOL 4 PAGE 513

MICROFILMED