

Of a Survey on Section **12** T. **3** R. **10** E. of the 4 P. M. in **MAGNOLIA** Township  
 Rock County, Wisconsin, made **JULY 29** 19**80**

COUNTY BUILDING  
 CITY OF JANESVILLE


I hereby certify that the following is a correct record of said survey as made by me.



County Surveyor.

**NW COR SEC 12**

FORMER COUNTY SURVEYOR DUG AND FOUND NOTHING. SET ALUM MON AT DOUBLE PROPORTIONATE DISTANCE SUR 3/8" x 32" Iron Bolt

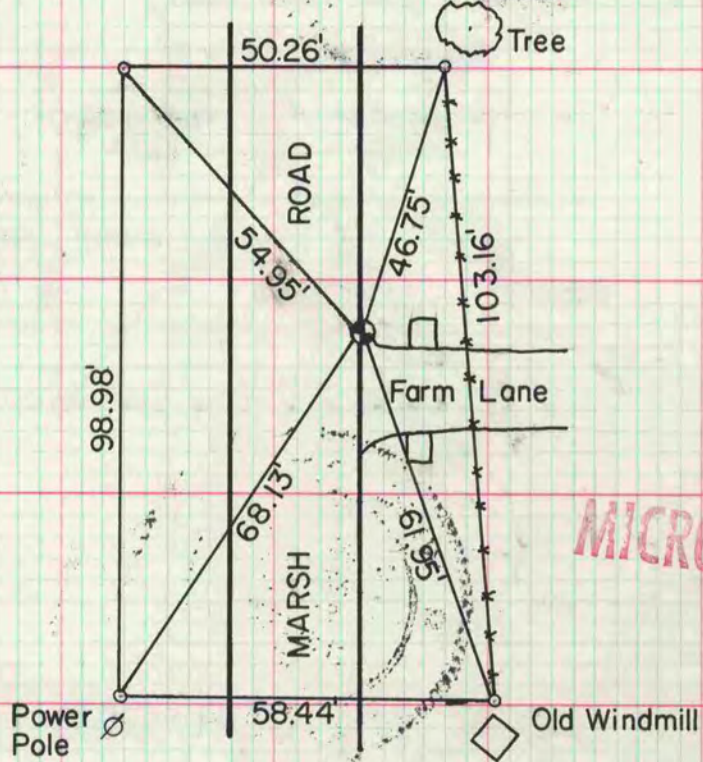

MICROFILMED

**SW COR SEC 12**

SET ALUM MONUMENT

