

MICROFILMED PLAT AND RECORD


109
V-3

Of a Survey on Section 14 T 2 R 11 E. of the 4 P. M. in Plymouth Township
Rock County, Wisconsin, made Mar. 22 the 1921

I hereby certify that the following is a correct record of said survey as made by me.

COUNTY BUILDING
CITY OF JANESVILLE

Alex. W. Ely
County Surveyor.

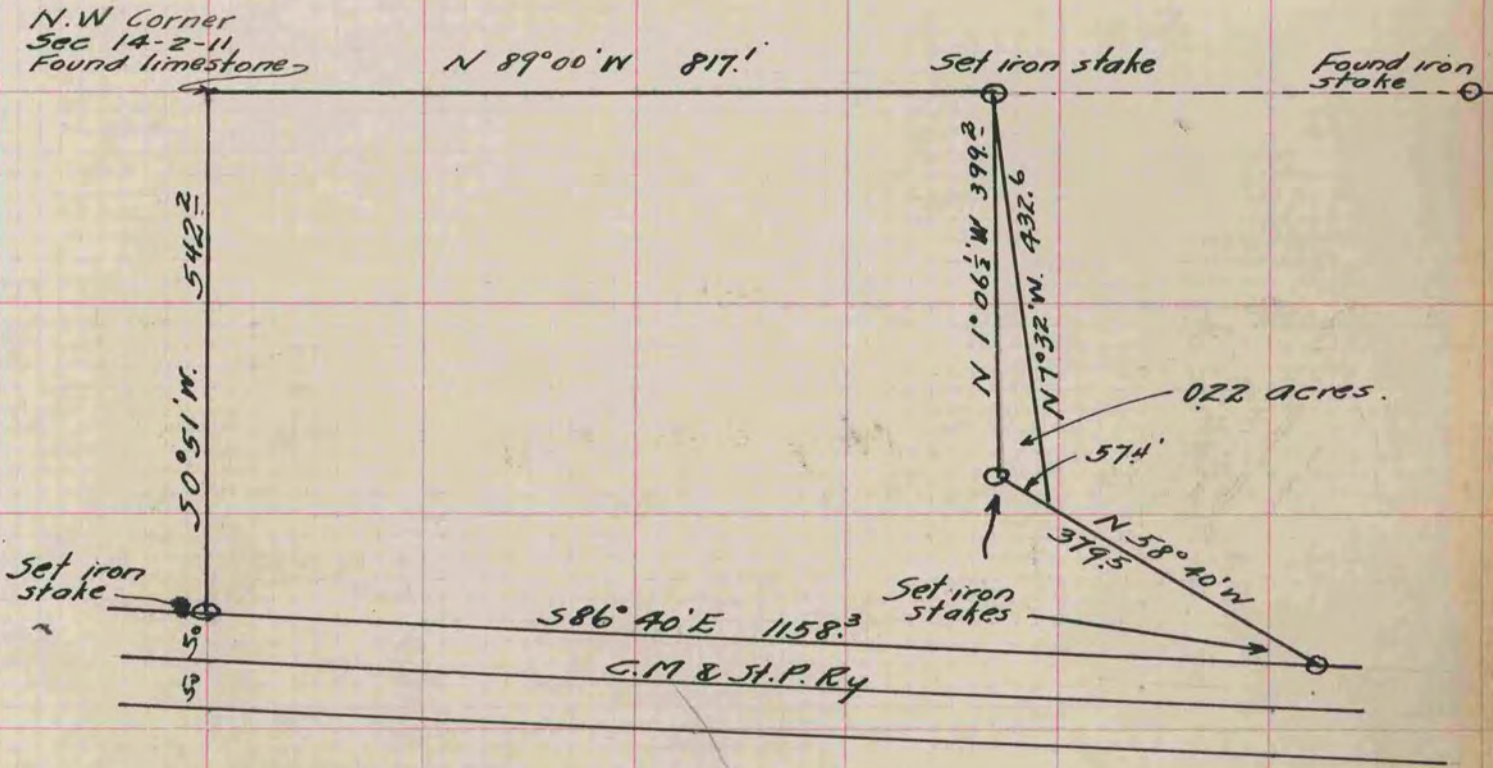

Mill Property -
J.W. Flint - owner
Hanover, Miss.