

PLAT AND RECORD

V-4 147

COUNTY BUILDING
CITY OF JANESVILLE

PG 150 BELOIT REC
12/8/75 DAB

Of a Survey on Section 12 T 4 R 10 E. of the 4 P. M. in UNION Township


Rock County, Wisconsin, made JULY the 26 1962

I hereby certify that the following is a correct record of said survey as made by me.

MICROFILMED

R. W. Besterman
County Surveyor.

S.T.H. 59

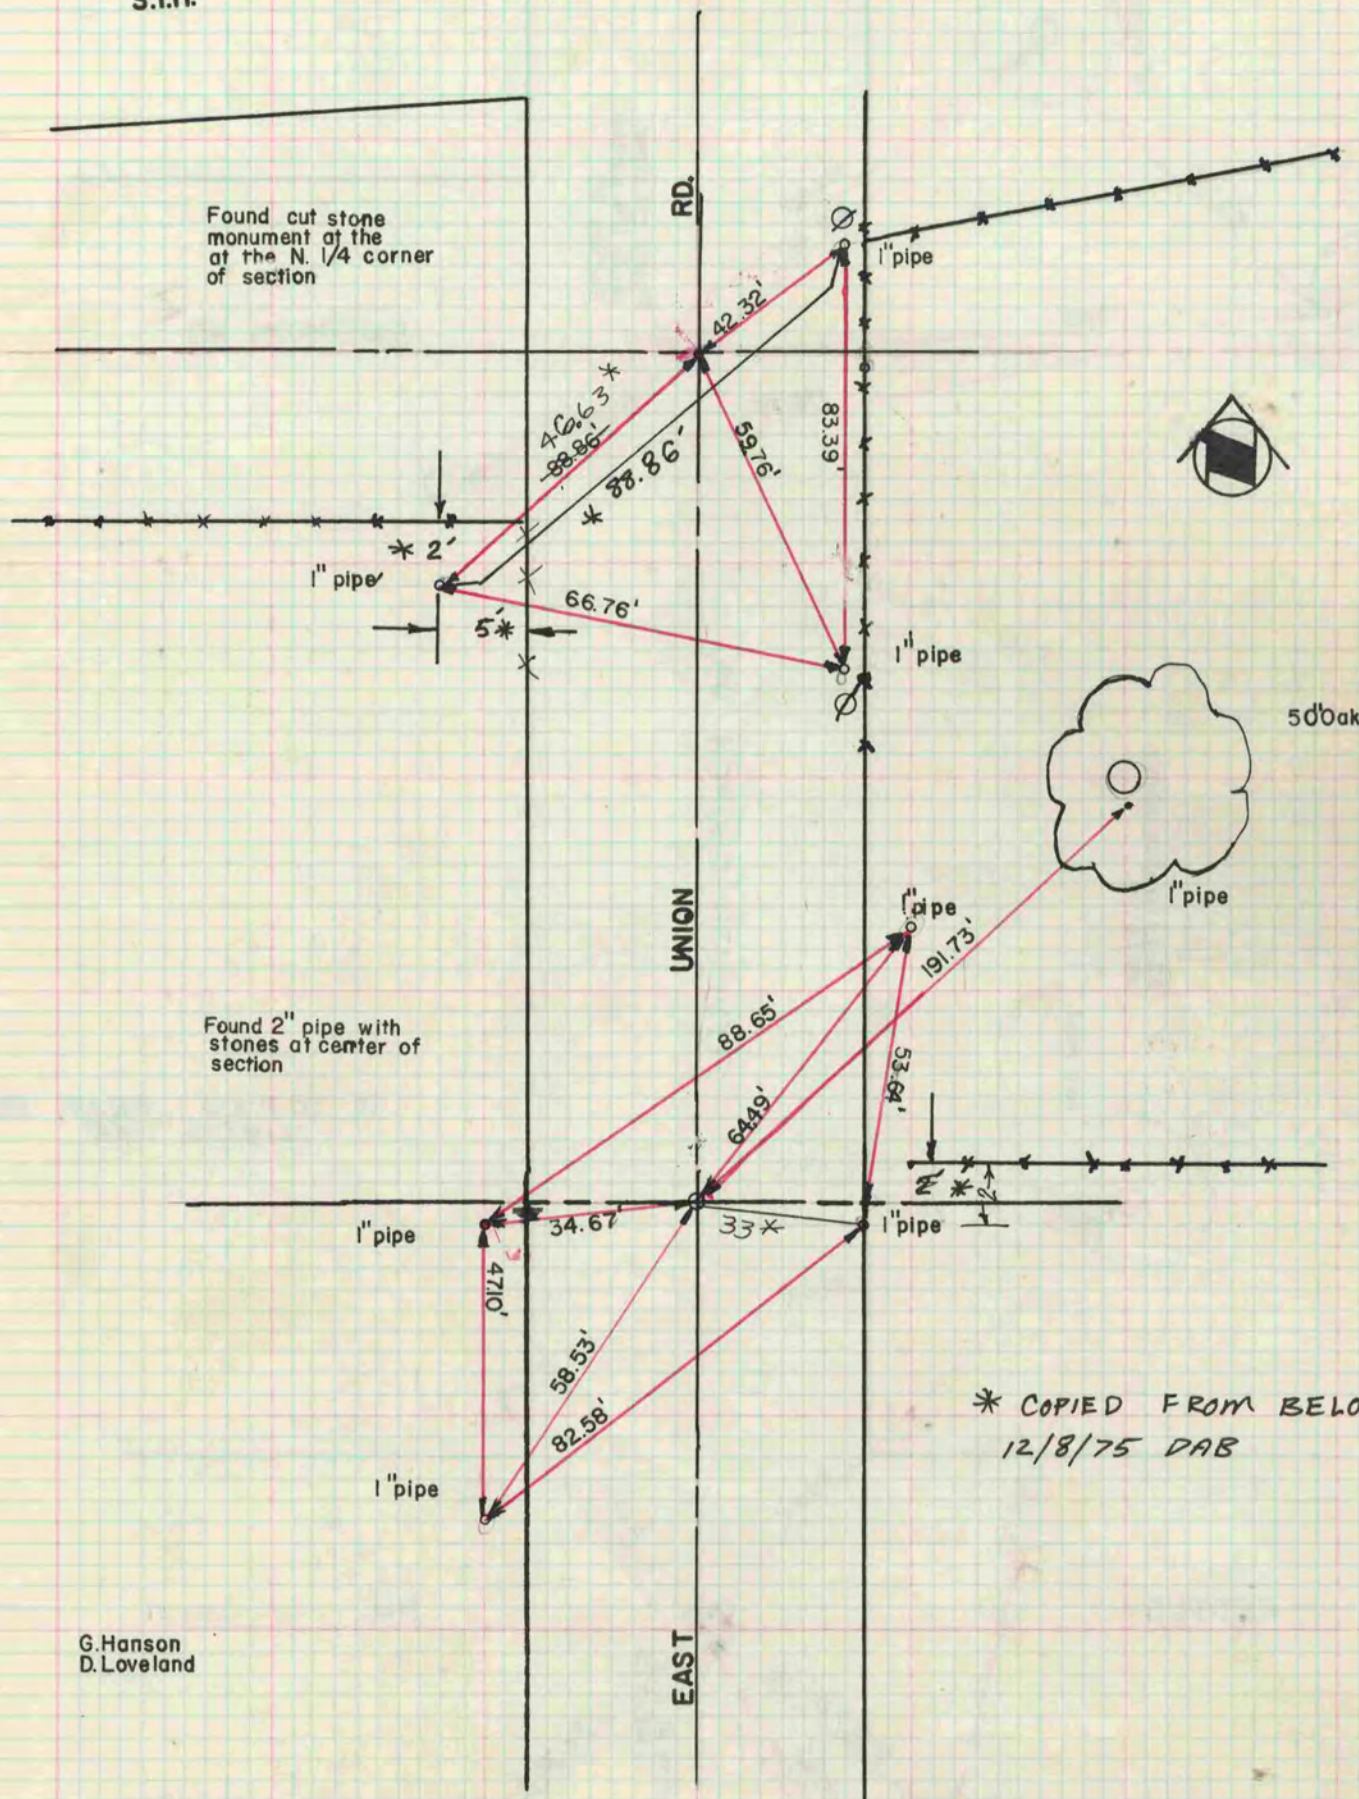

G. Hanson
D. Loveland

P 150, BELOIT