


44
VI MICROFILMED PLAT AND RECORD

Of a Survey on Section 9 T 2 R 10 E. of the 4 P. M. in Spring Valley Township
 Rock County, Wisconsin, made June the 13th & 14th 1855

I hereby certify that the following is a correct record of said survey as made by me.

COUNTY BUILDING
 CITY OF JANESVILLE

(Signed) Joseph Church
 R.H.B. County Surveyor.

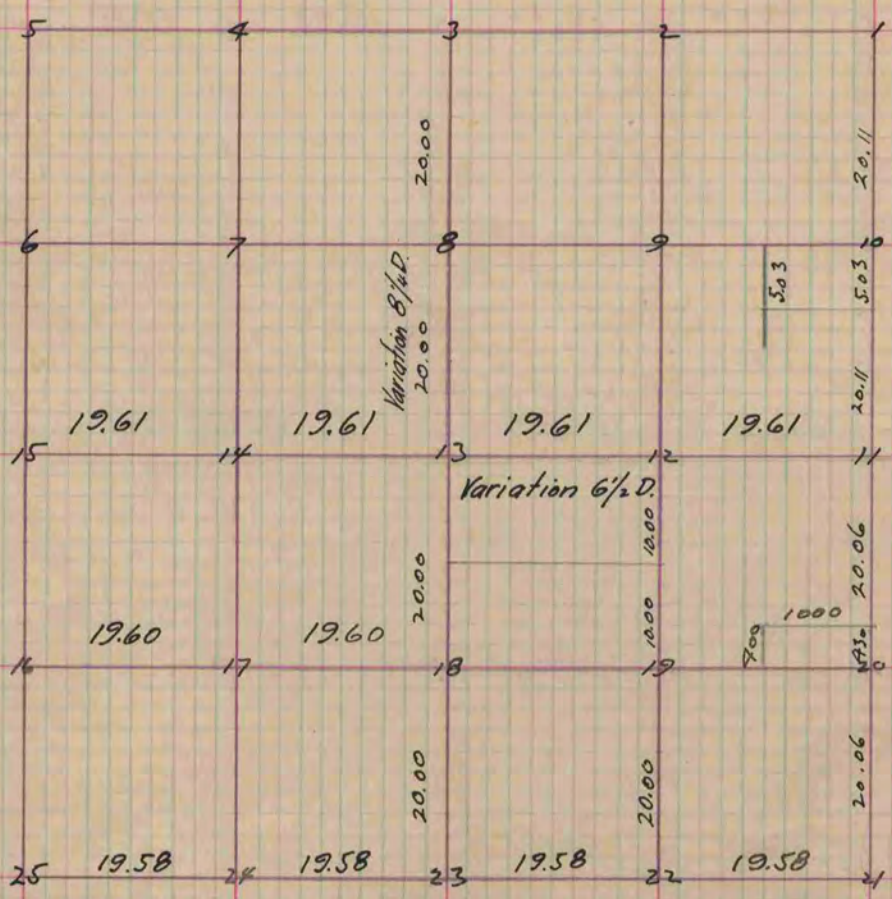

- Fig 23 Bur 0 12 N 13 1/2 W 507 links
- 14 S 4 1/2 E 511 "
- " 8 Bur 0 20 S 72 1/2 E 19 "
- 18 S 84 W 77 "
- " 13 Bur 0 18 S 19 1/4 W 77 "
- 14 S 61 W 47 1/2 "
- " 14 Bur 0 20 N 36 W 149 "
- 20 S 35 1/2 W 135 "
- " 17 " 14 S 71 1/2 W 46 "
- 15 S 82 1/2 E 34 "
- " 18 " 14 S 1 1/2 W 48 "
- 14 N 18 E 81 "

- Fig. 22 Br. 0 20 N 54 W 188
- 18 S 33 1/2 W 35
- " 12 Br. 0 12 N 34 W 53
- 20 S 25 E 107 1/2
- " 19 Br 0 14 S 68 1/2 E 52
- 14 N 83 E 40
- " 20-24 S 55 W 52
- 10 N 81 1/2 E 57
- " 9 14 N 26 1/2 W 27 1/2
- 16 S. 74 E 36

The above survey was made Feb 13th 1856
 (Signed) Joseph Church, County Surveyor
 R.H.B.

Copied from Page 45 Vol. 1. Original County Surveyors Record