

Of a Survey on Section 13 1 12 E. of the 4 P. M. in NEWARK BELOIT Township


Rock County, Wisconsin, made OCTOBER the 13th 1960

I hereby certify that the following is a correct record of said survey as made by me.

Robert A. Hummer

County Surveyor.

MICROFILMED
THE REG. S. BARNARD COMPANY, ST. LOUIS

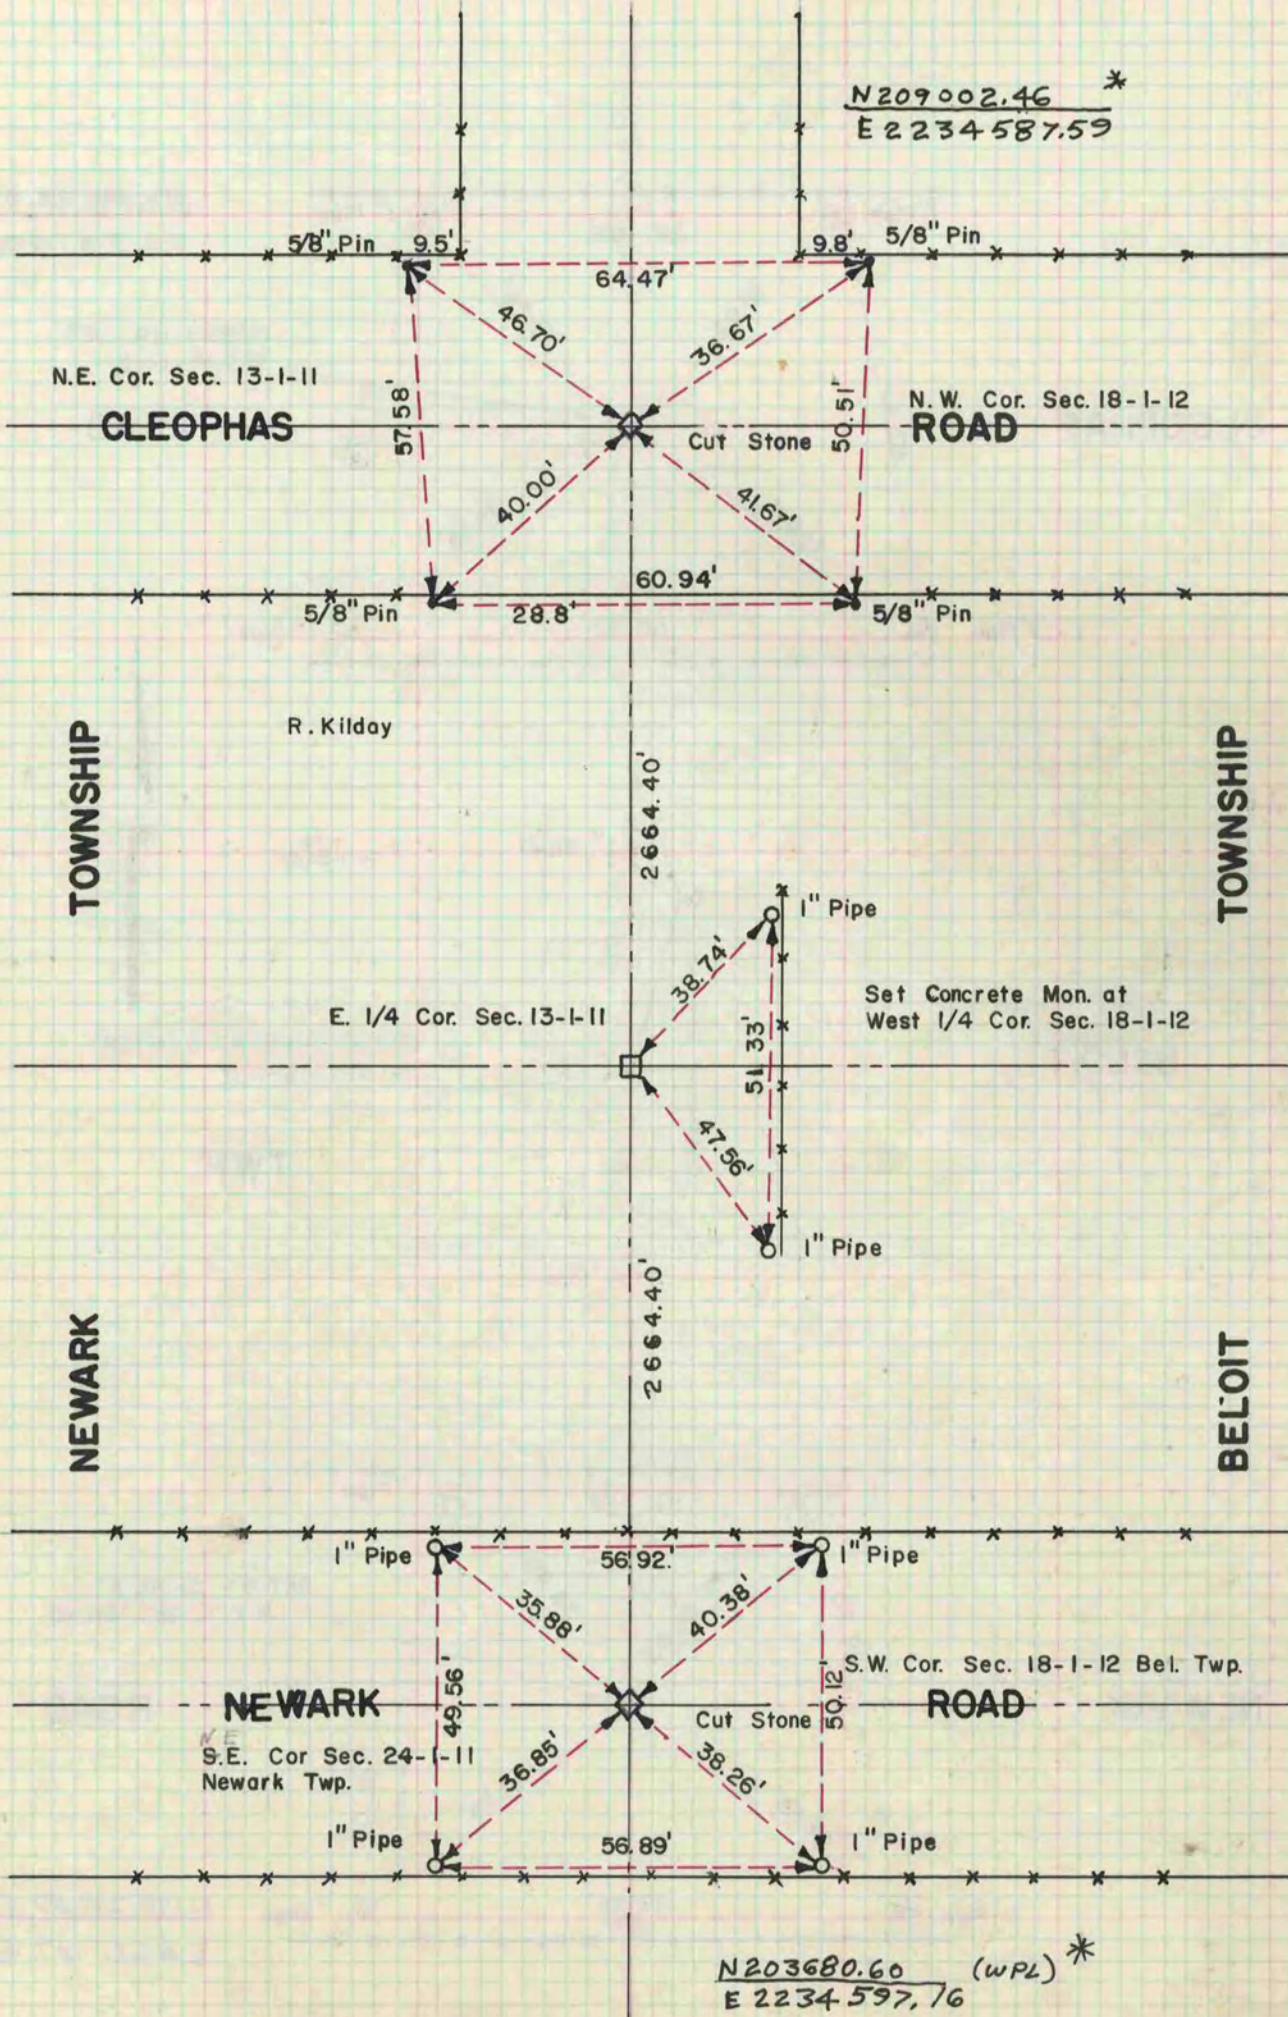

* COPIED FROM BELOIT
REC 12/8/75 DAB