

190
V-4

PLAT AND RECORD

COUNTY BUILDING
CITY OF JANESVILLE

Of a Survey on Section 31 T 2 R 10 E. of the 4 P. M. in SPRING VALLEY Township

Rock County, Wisconsin, made JULY the 16 1964

I hereby certify that the following is a correct record of said survey as made by me.


W. B. Atkinson Jr.

County Surveyor.

MICROFILMED

THE GEO. D. SARGENT COMPANY, ST. LOUIS

N

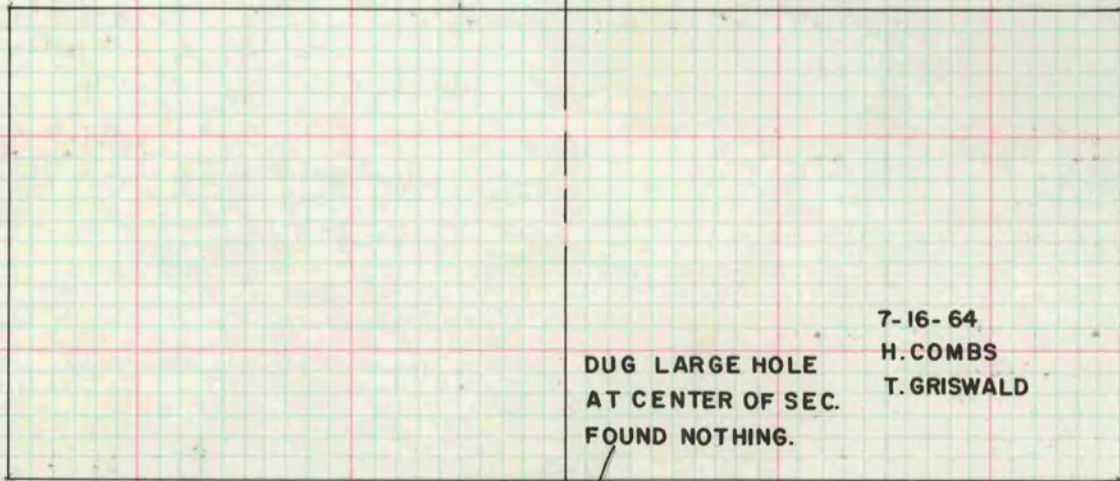

DUG LARGE HOLE
AT CENTER OF SEC.
FOUND NOTHING.

7-16-64.
H. COMBS
T. GRISWALD

31

HAFEMAN

ROAD

SVEOM
ROAD

DUG LARGE HOLE
AT E. 1/4 CORNER
FOUND NOTHING.
7-16-64.

C.T.H. "T"