

PLAT AND RECORD

439
v-4

CITY OF JANESVILLE
COUNTY BUILDING

COUNTY BUILDING
CITY OF JANESVILLE

Of a Survey on Section 30 T 4 R 10 E. of the 4 P. M. in Porter Union Township


Rock County, Wisconsin, made the 1970

I hereby certify that the following is a correct record of said survey as made by me.

MICROFILMED

R.H. Batteman

County Surveyor.

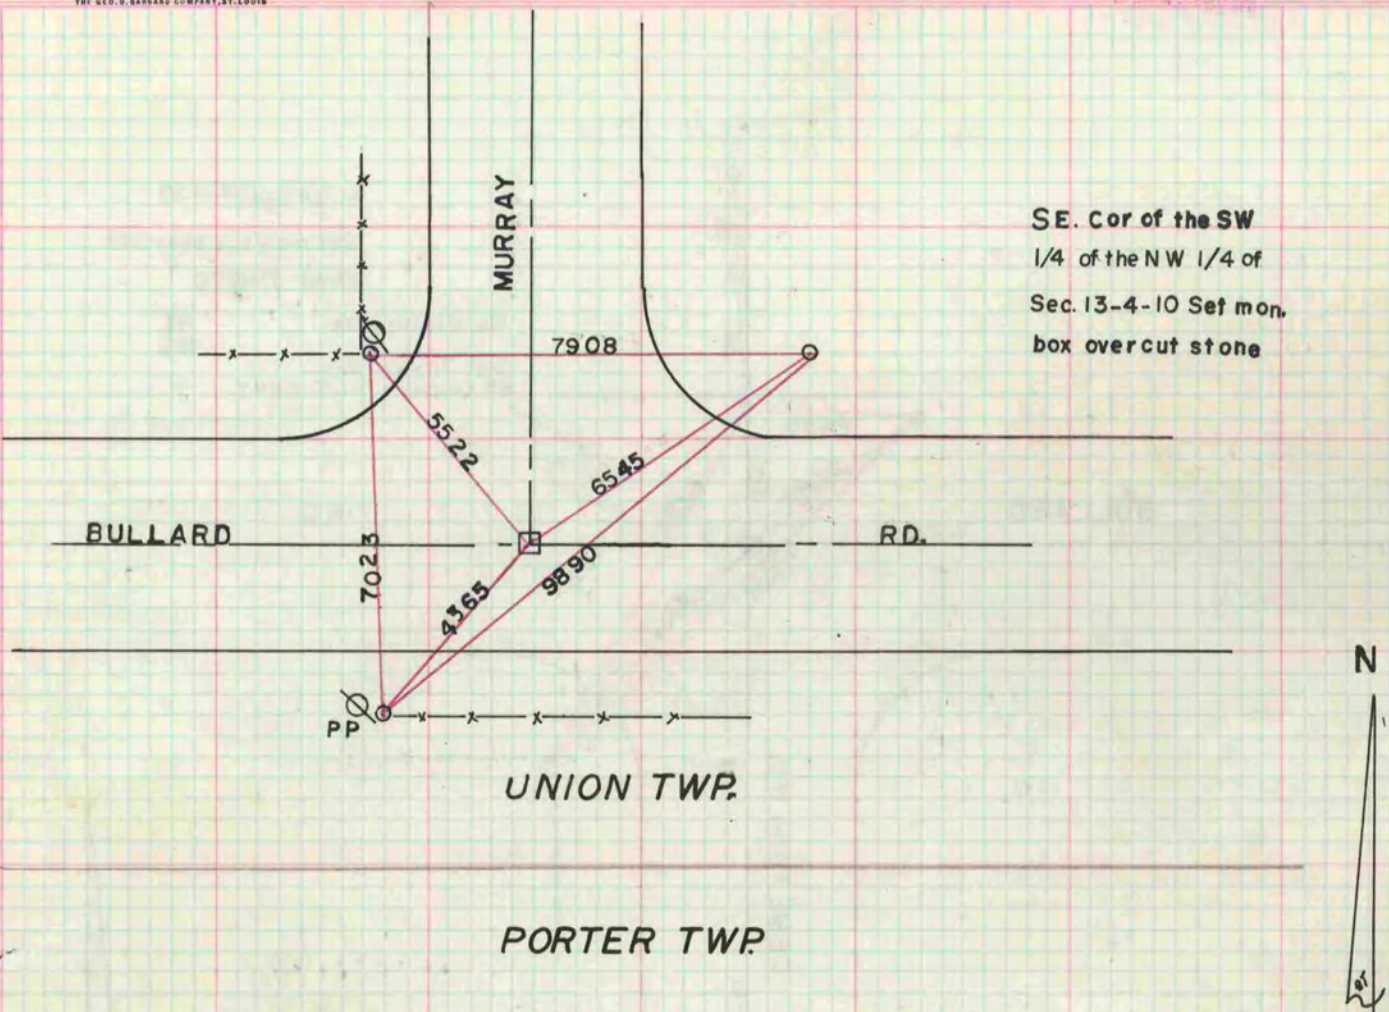

SEE Vol. 4, P. 493
FOR RE-REFERENCES
4/5/71

