

PLAT AND RECORD

ROCK COUNTY BUILDING
CITY OF JANESVILLE

Of a Survey on Section 6 T. 4N, R. 11 E. of the 4 P. M. in PORTER Township


Rock County, Wisconsin, made MAY the 13th 1959

I hereby certify that the following is a correct record of said survey as made by me.

R. B. Adams

County Surveyor.

MICROFILMED

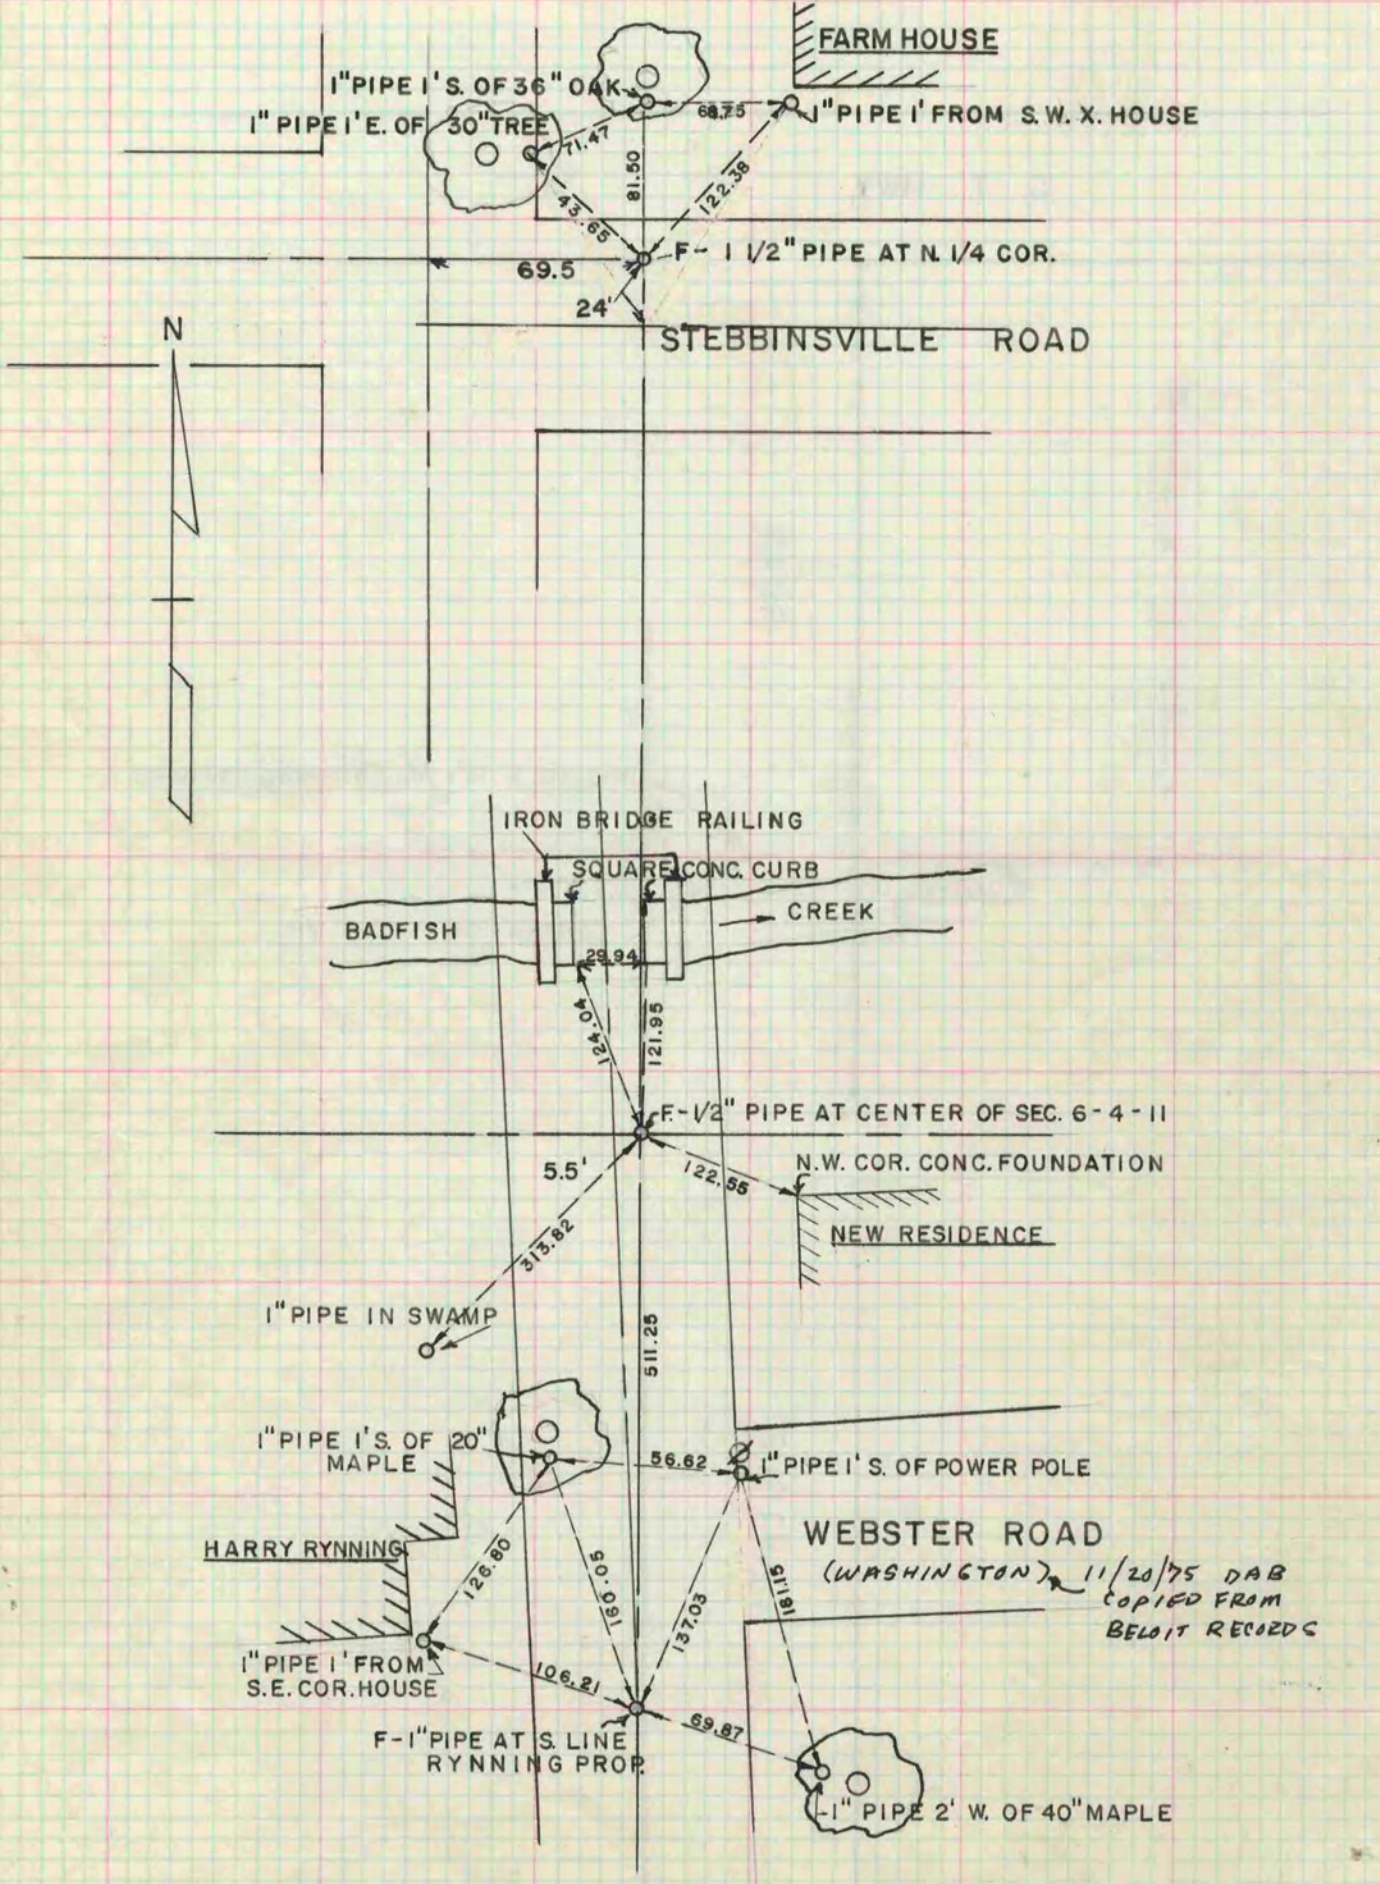

11/20/75 DAB
COPIED FROM
BELOIT RECORDS