

PLAT AND RECORD

91
V-4

COUNTY BUILDING
CITY OF JANESVILLE

Of a Survey on Section 23-24-25-26 T 1 R 11 E. of the 4 P. M. in NEWARK Township


Rock County, Wisconsin, made APRIL the 20th 1961

MICROFILMED

I hereby certify that the following is a correct record of said survey as made by me.

R. H. Batten
County Surveyor.

THE GEO. D. BARRETT COMPANY, ST. LOUIS

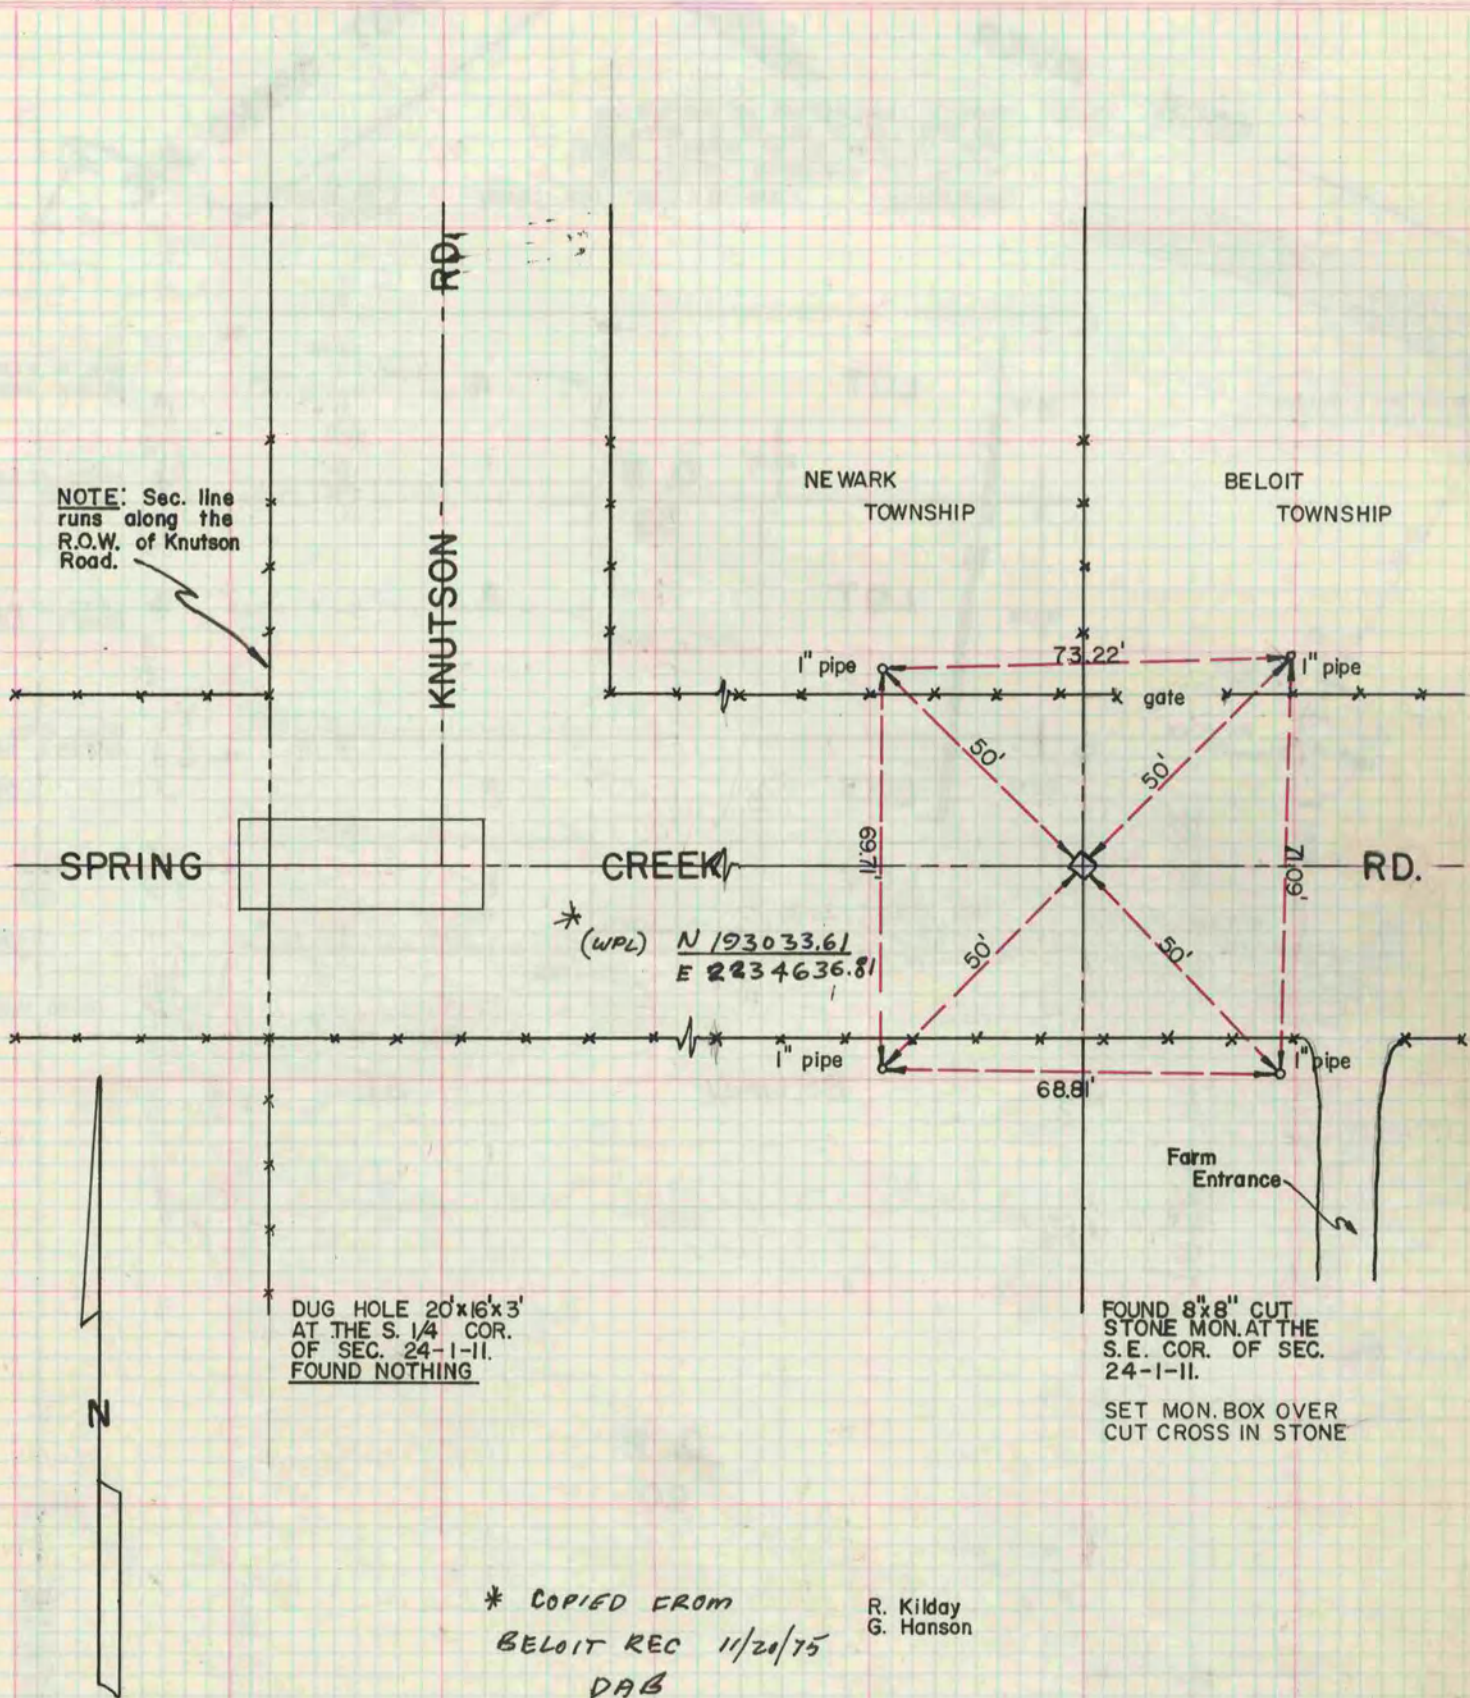

NOTE: Sec. line runs along the R.O.W. of Knutson Road.

DUG HOLE 20'x16'x3' AT THE S. 1/4 COR. OF SEC. 24-1-11. FOUND NOTHING

FOUND 8"x8" CUT STONE MON. AT THE S.E. COR. OF SEC. 24-1-11. SET MON. BOX OVER CUT CROSS IN STONE

* COPIED FROM BELOIT REC 11/20/75 DAB

R. Kilday
G. Hanson