

PLAT AND RECORD

97
v-4

ROCK COUNTY BUILDING
CITY OF JANESVILLE

Of a Survey on Section 4 T 4 R 10 E. of the 4 P. M. in UNION Township


Rock County, Wisconsin, made APRIL the 26th 1961

I hereby certify that the following is a correct record of said survey as made by me.

R. B. Egan Jr.

County Surveyor.

MICROFILMED
THE GEO. BARNARD COMPANY, ST. LOUIS

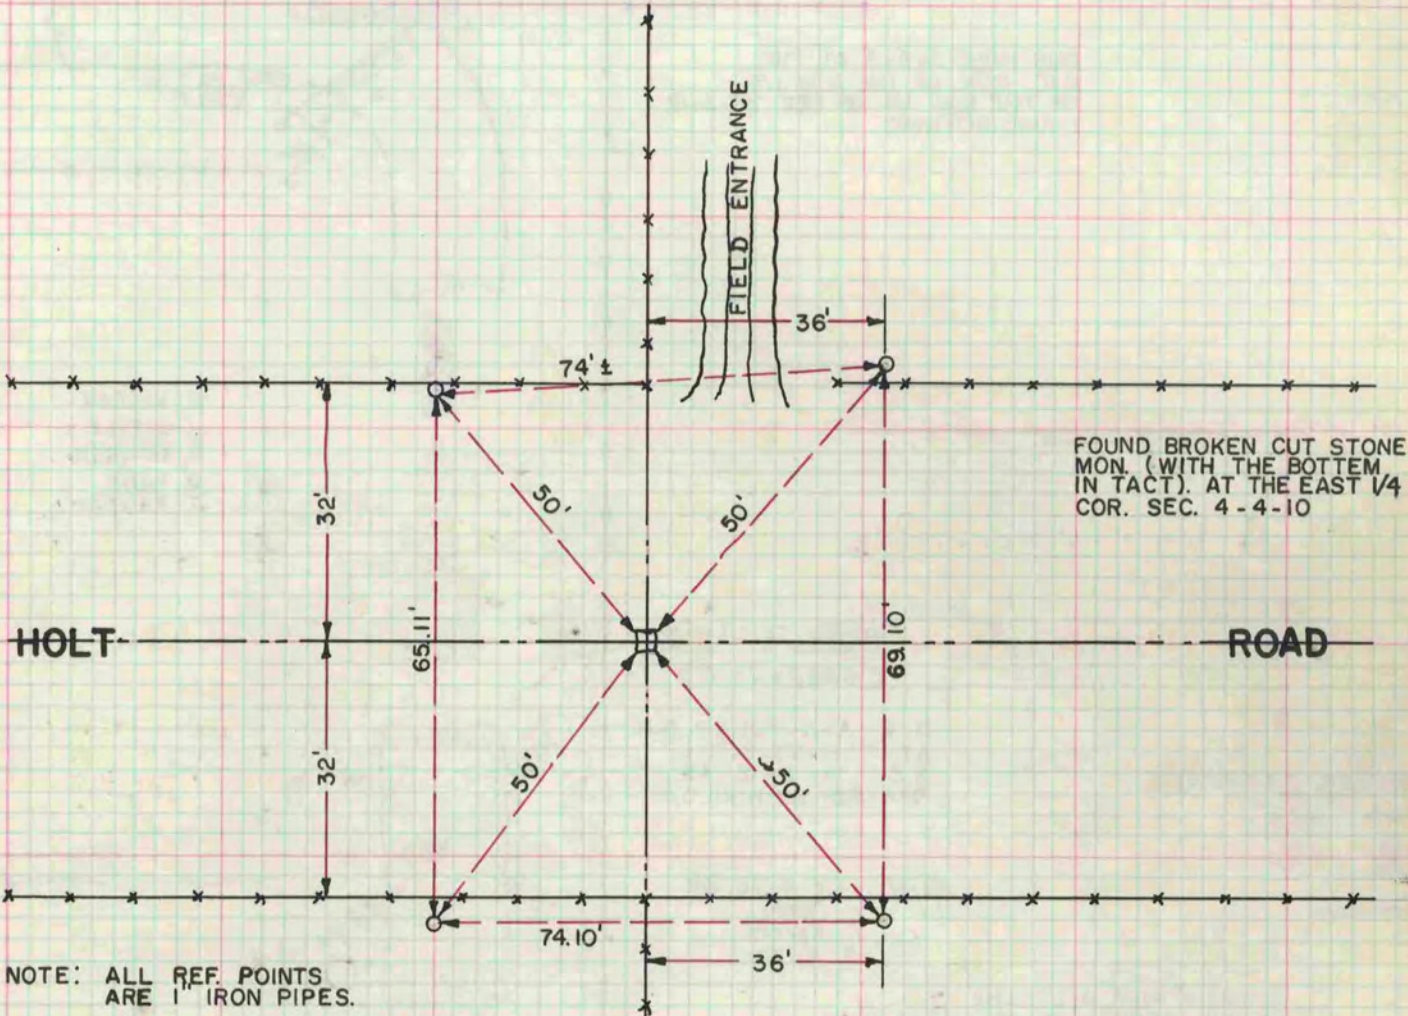

R. KILDAY
G. HANSON
H. LITTLE

