

# PLAT AND RECORD

143  
vjw

COUNTY BUILDING  
CITY OF JANESVILLE

Of a Survey on Section 5 T 4 R 11 E. of the 4 P. M. in PORTER Township


Rock County, Wisconsin made JULY the 9 1962

**MICROFILMED**

I hereby certify that the following is a correct record of said survey as made by me.

*R. B. Atkinson*

County Surveyor.

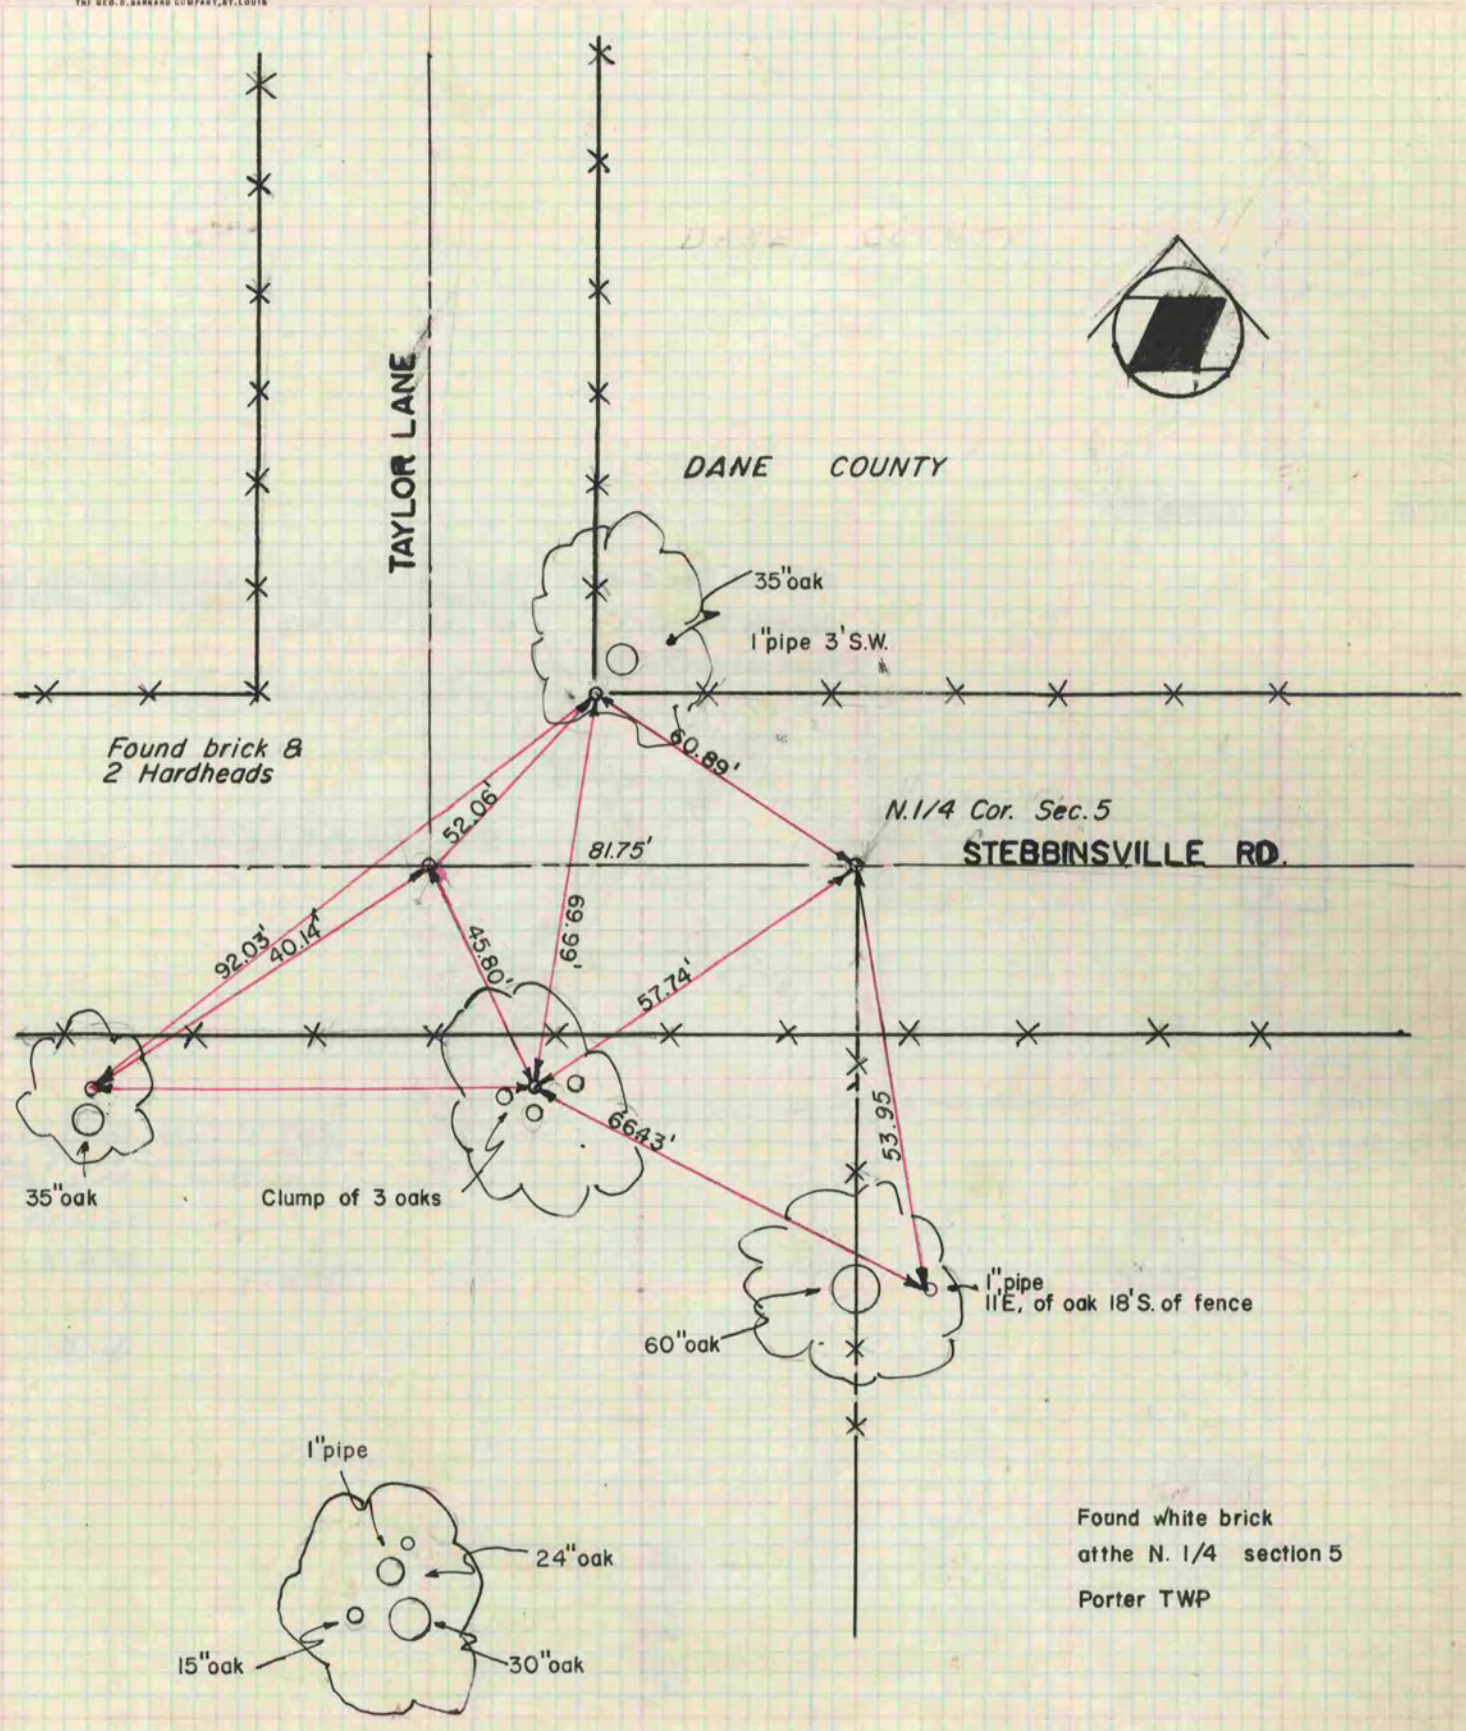

G. Hanson  
D. Loveland