

PLAT AND RECORD

COUNTY BUILDING
CITY OF JANESVILLE

Of a Survey on Section 25 T. 1 N., R. 13 E. of the 4 P. M. in TURTLE Township


Rock County, Wisconsin, made JUNE the 8th 1959

I hereby certify that the following is a correct record of said survey as made by me.

R. B. Batteman

County Surveyor.

MICROFILMED

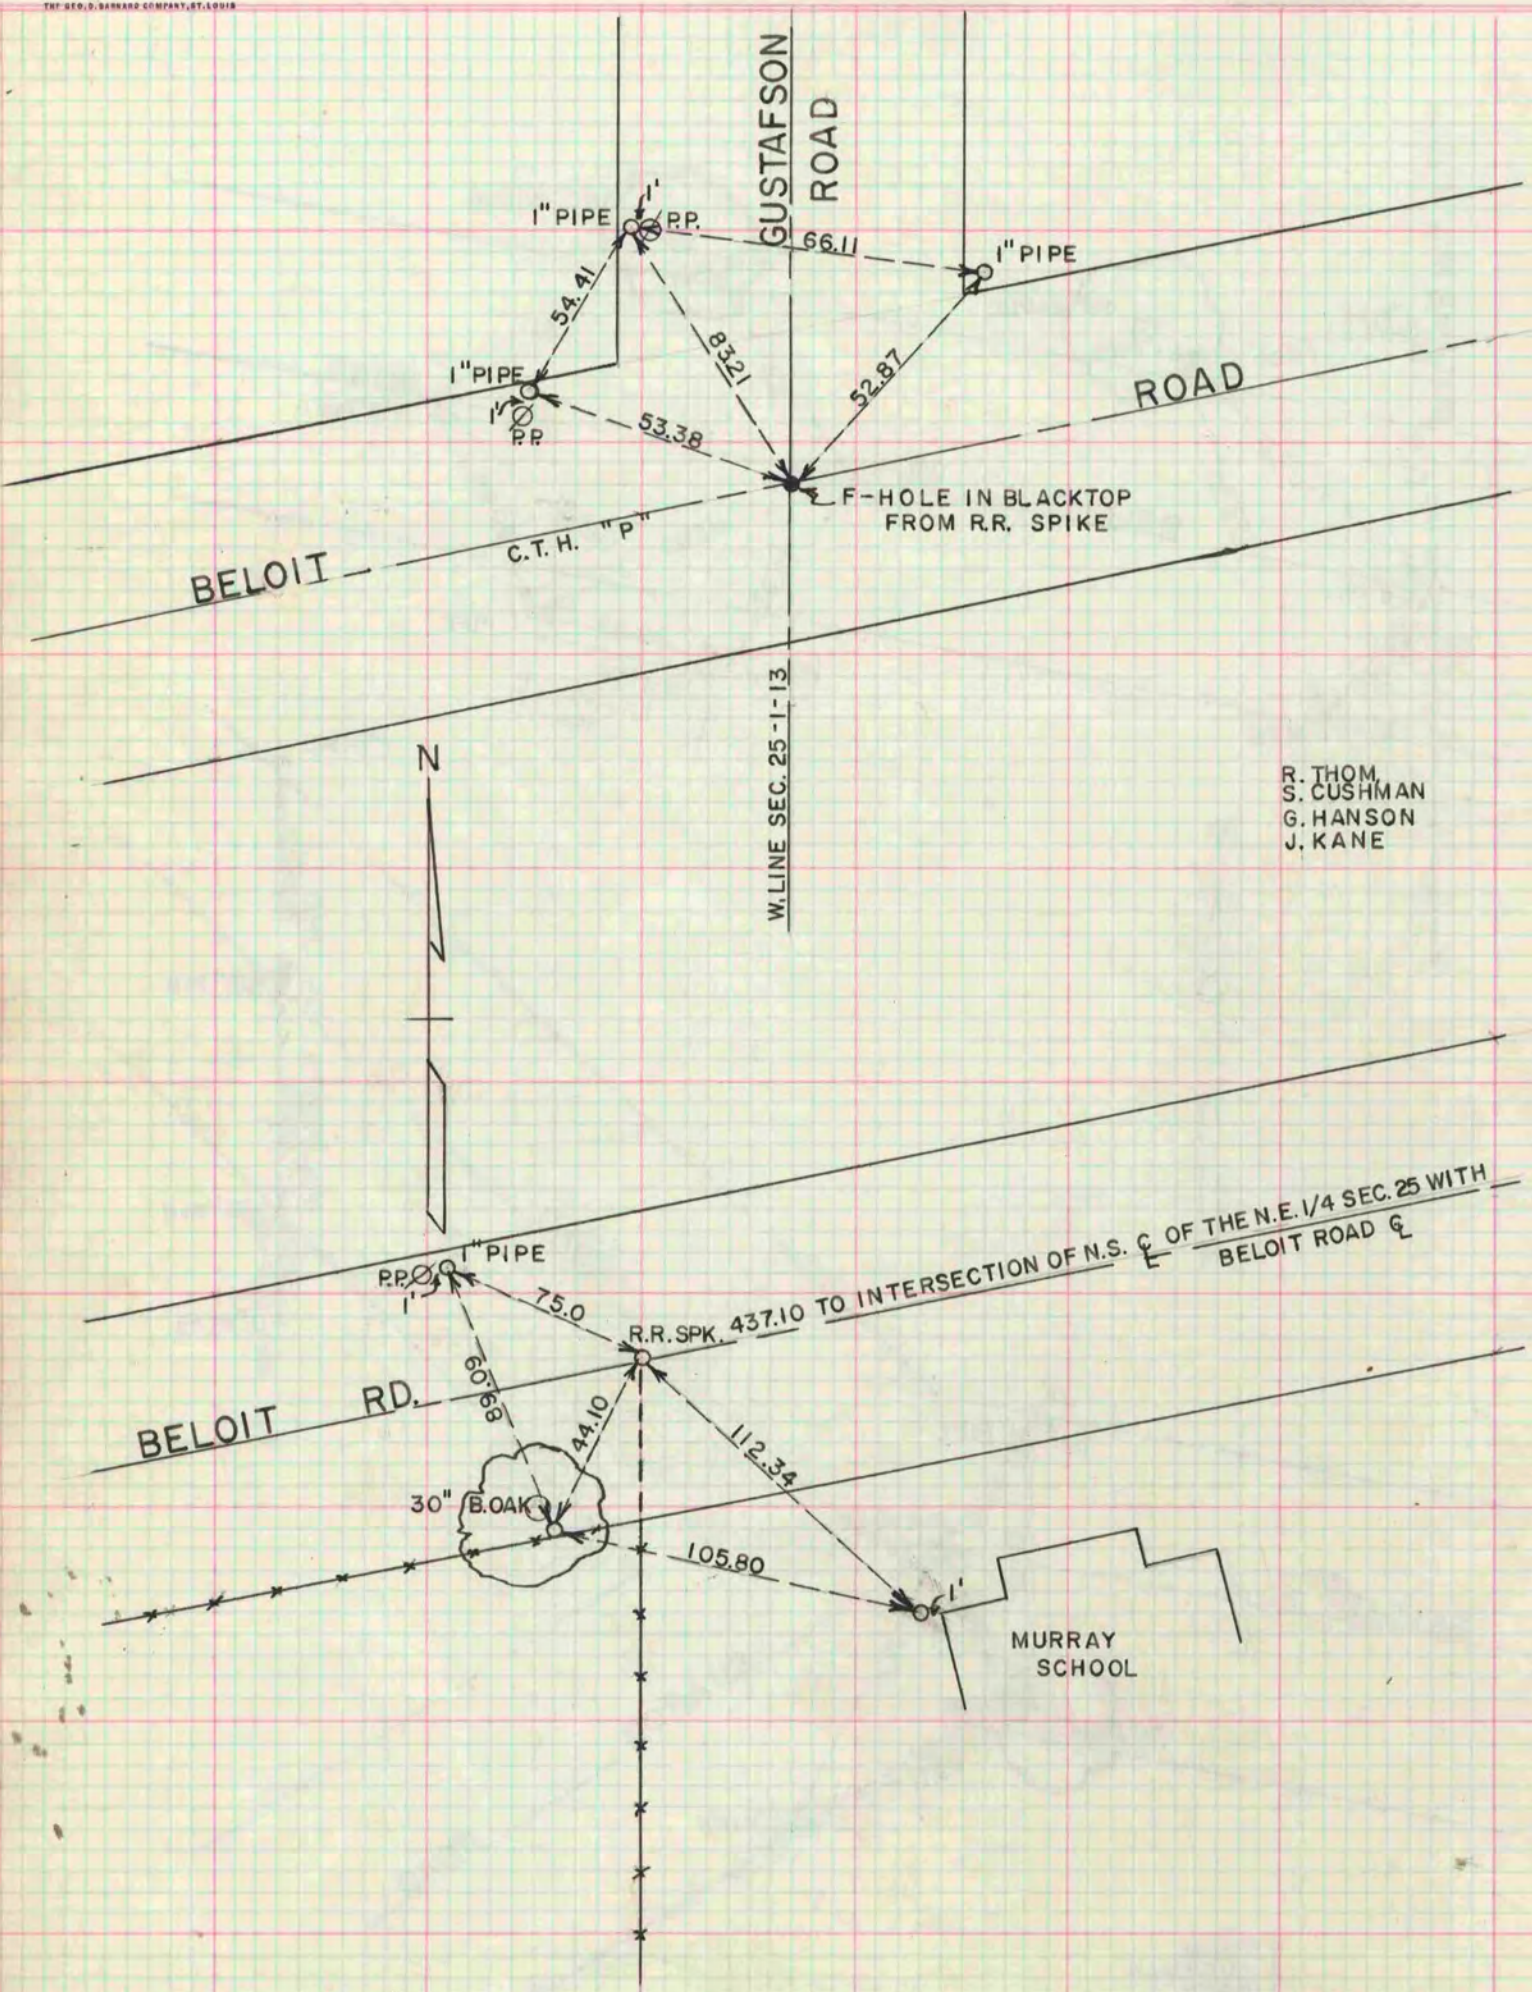

R. THOM
S. CUSHMAN
G. HANSON
J. KANE