

MICROFILMED PLAT AND RECORD


Of a Survey on Section 12 T 3 R 10 E. of the 4 P. M. in Magnolia Township
Rock County, Wisconsin, made August the 1855

I hereby certify that the following is a correct record of said survey as made by me.

COUNTY BUILDING
CITY OF JANESVILLE

(Signed) Joseph Church

County Surveyor.

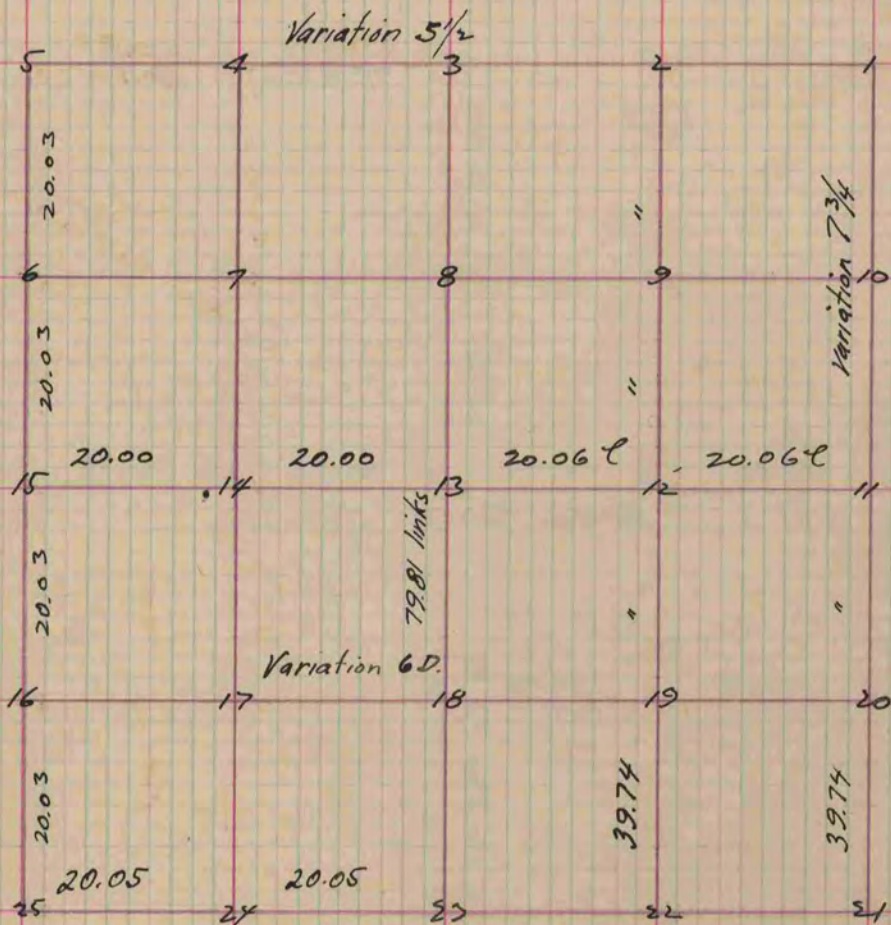

Stakes were drove in the ground at
figures 6 - 7 - 8 - 9 + 10
No bearings

Copied from Page 49 Original County Surveyors Record