

PLAT AND RECORD

87
V-4


COUNTY BUILDING
CITY OF JANESVILLE

Of a Survey on Section 28 T 4 R 13 E. of the 4 P. M. in MILTON Township

Rock County, Wisconsin, made NOVEMBER the 10th 1960


MICROFILMED

I hereby certify that the following is a correct record of said survey as made by me.

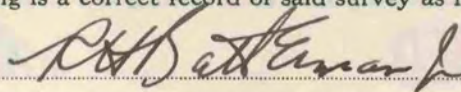

County Surveyor

NOTE: THIS PAGE WAS IN THE BELoit RECORDS.
11/20/75 DAB

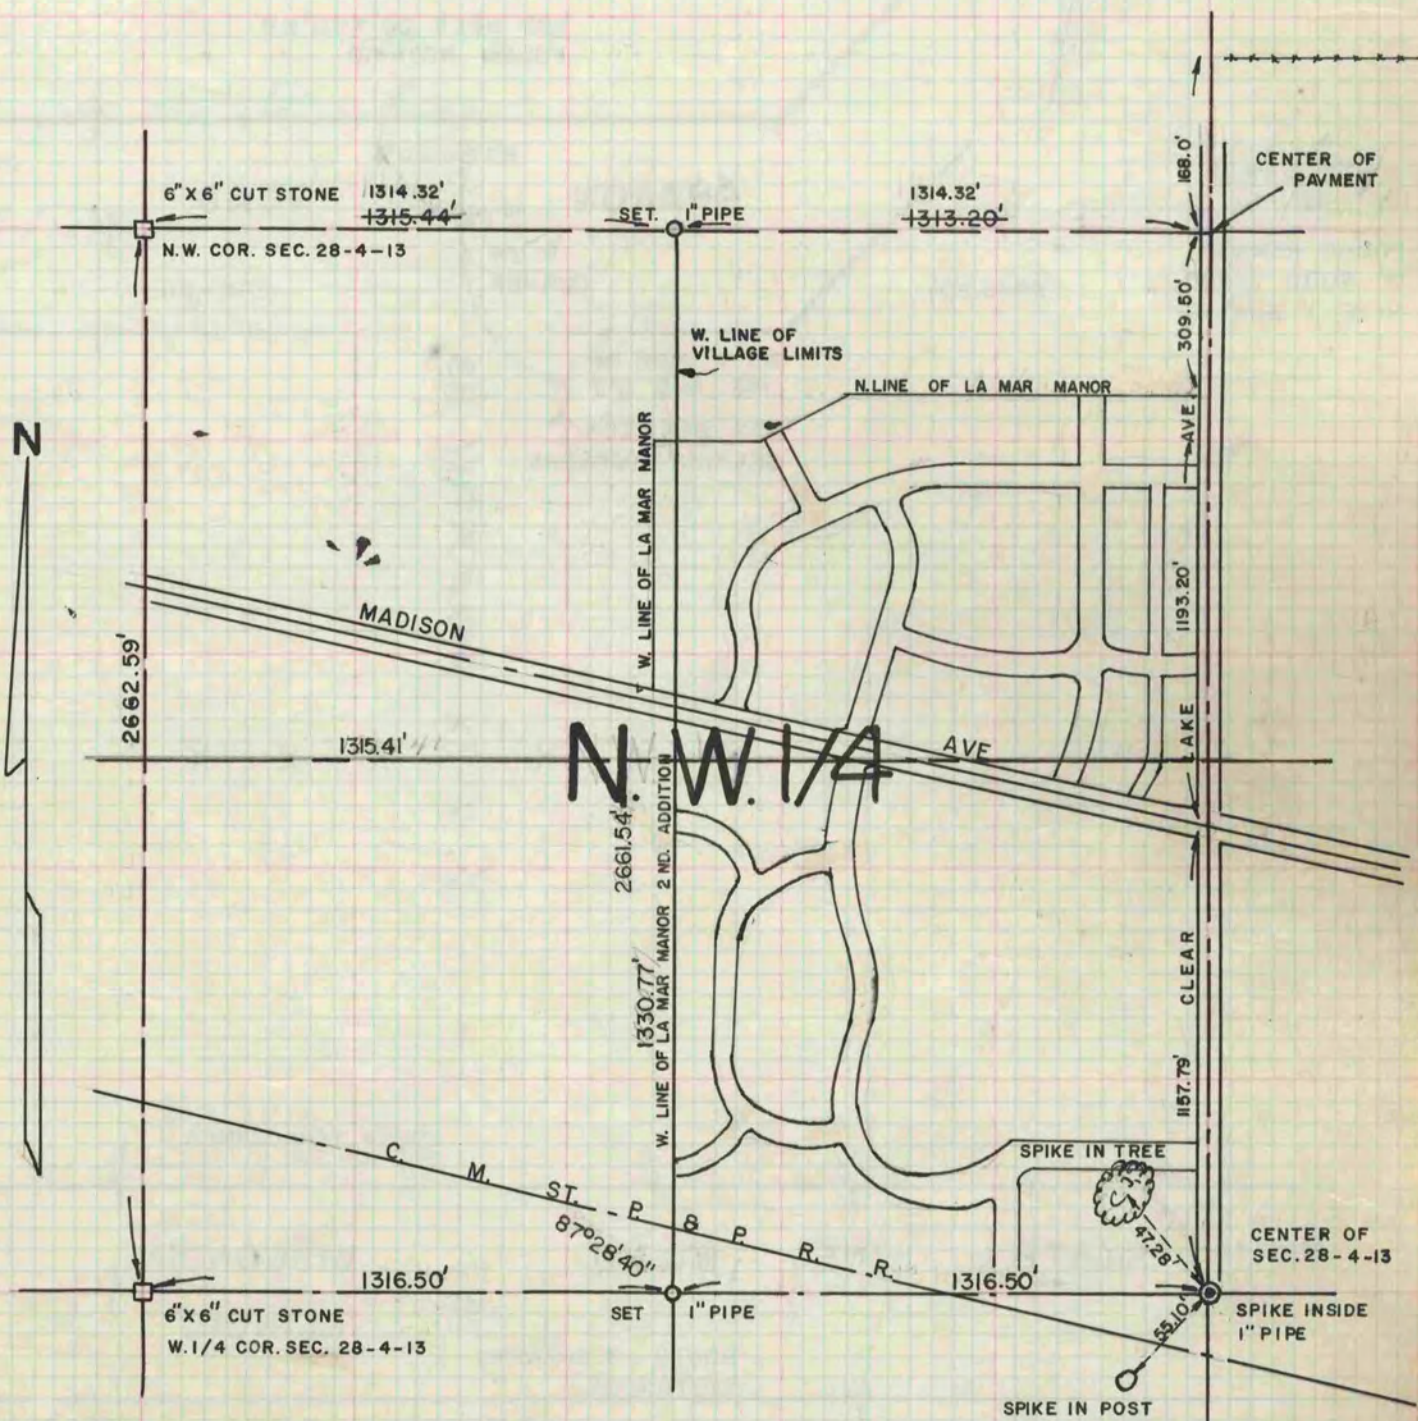

91.87
117.11
237.45