

PLAT AND RECORD VOL. 5

31 V-5




COUNTY BUILDING
CITY OF JANESVILLE

Of a Survey on Section 13 T 3 N. R. 13 E. of the 4 P. M. in HARMONY Township
Rock County, Wisconsin, made JUNE the 21st 1973

I hereby certify that the following is a correct record of said survey as made by me.

Hugh J. Lee
County Surveyor.

MICROFILMED

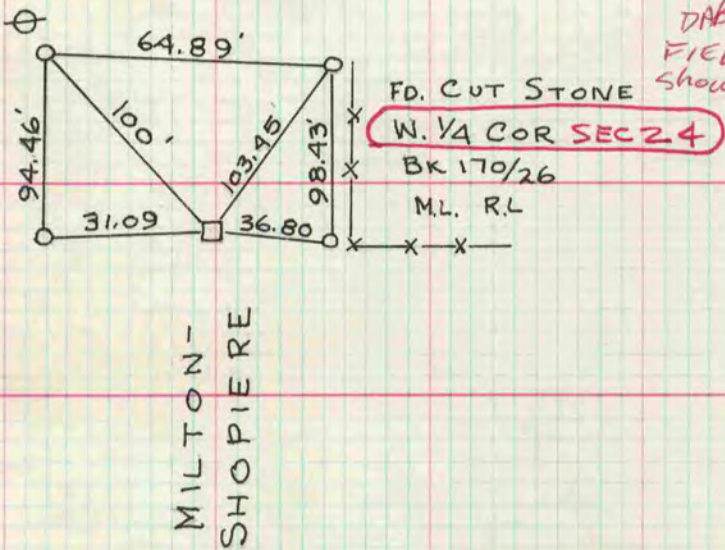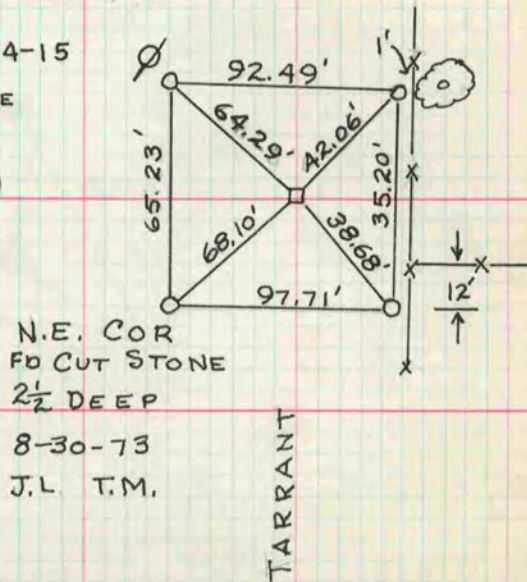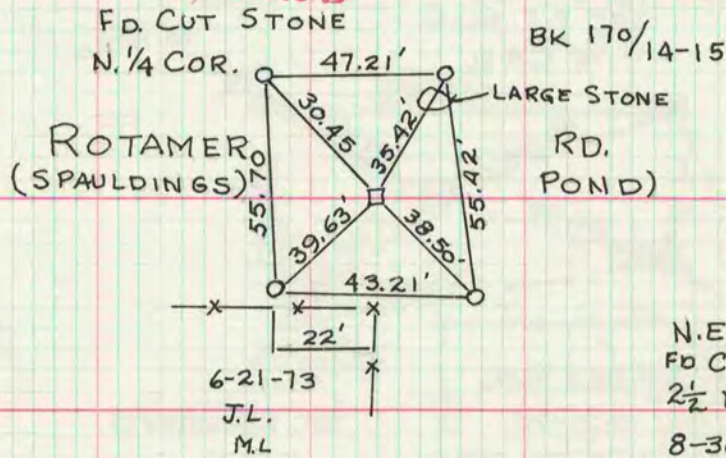

DAB 4/2/84
FIELD BOOK
Shows sec 13

