

# PLAT AND RECORD

COUNTY BUILDING  
CITY OF JANESVILLE

Of a Survey on Section 17 T 3 R 11 E. of the 4 P. M. in CENTER Township


Rock County, Wisconsin, made AUGUST the 14

I hereby certify that the following is a correct record of said survey as made by me.




## NW COR SEC 17

DUG & FOUND 2.5' DEEP 16 X 7 X 504 HH SET  
ALUM MON ON TOP OF STONE

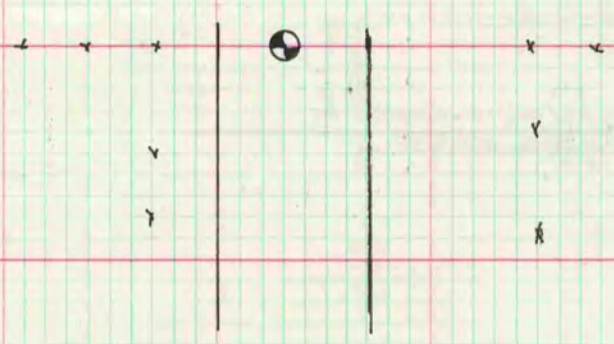

## NE COR SEC 17

OCCUPATION IS IN HARMONY WITH ORIGINAL GOV DISTANCE  
TO SOUTH, EAST, & WEST SET ALUM MON

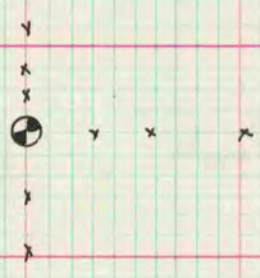

**MICROFILMED**