

Of a Survey on Section 14 & 23 T 2 N R 10 E. of the 4 P. M. in SPRING VALLEY Township


Rock County, Wisconsin, made October the 14 1975

I hereby certify that the following is a correct record of said survey as made by me.

Donald Baines



MICROFILMED

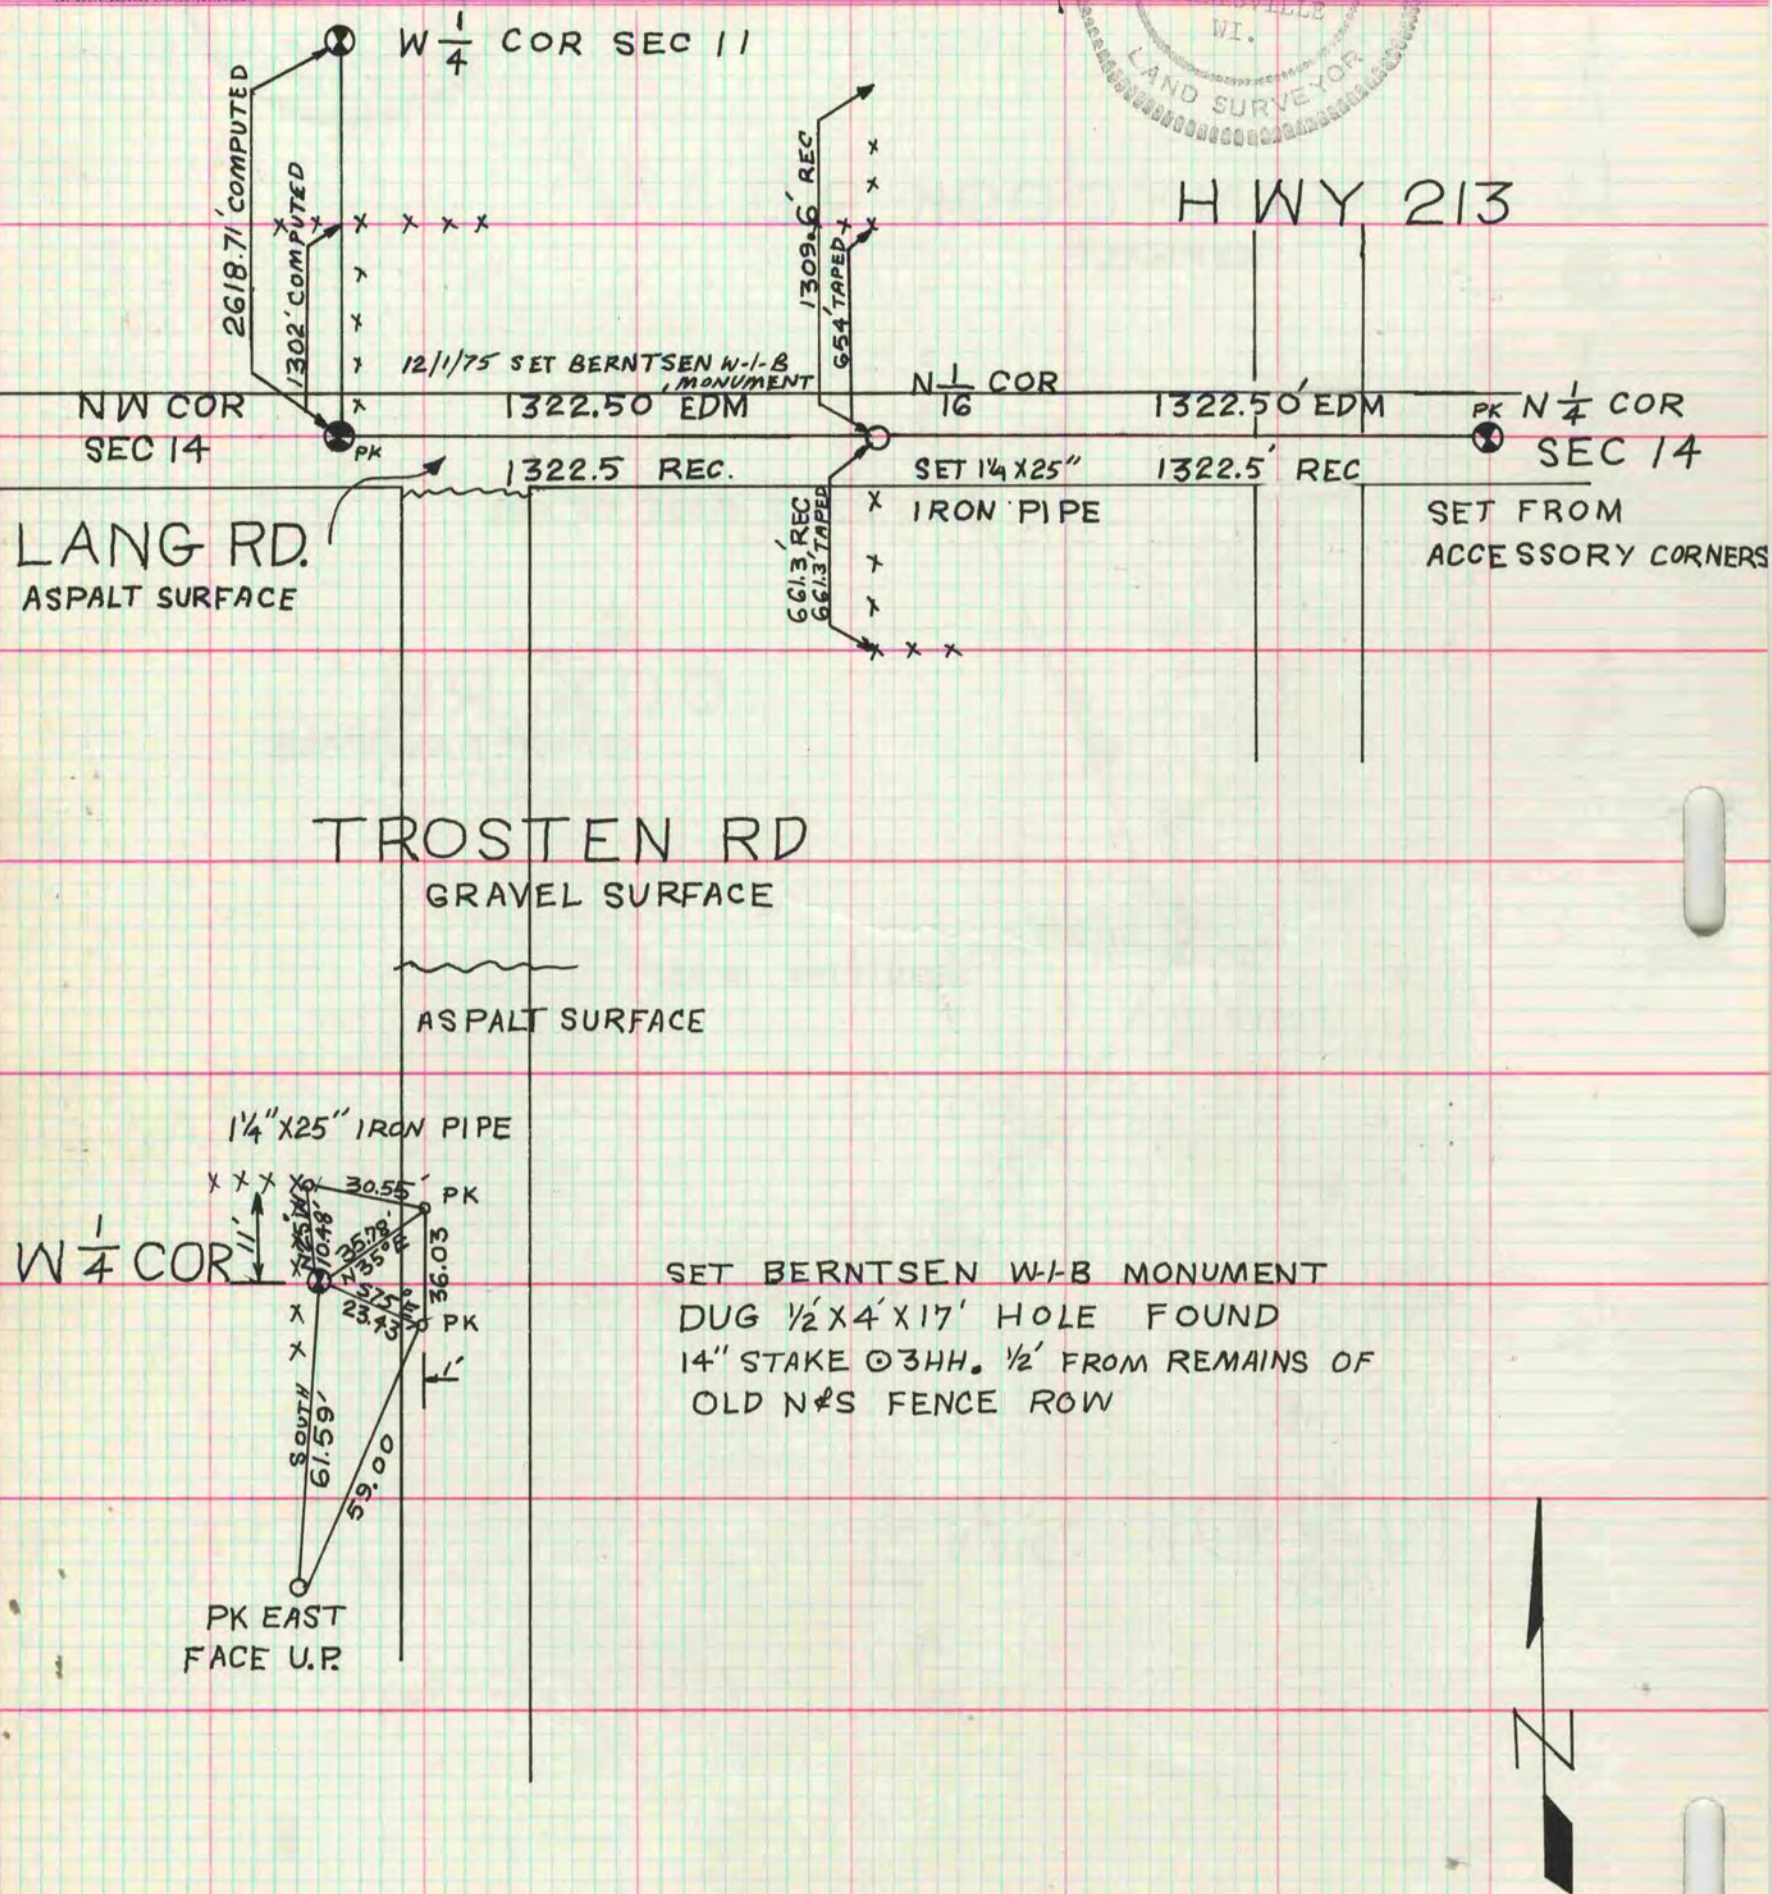

SET BERNTSEN W-I-B MONUMENT
DUG 1/2 X 4 X 17' HOLE FOUND
14" STAKE @ 3HH. 1/2' FROM REMAINS OF
OLD N&S FENCE ROW