

# VOL. 5 PLAT AND RECORD

COUNTY BUILDING  
CITY OF JANESVILLE

Of a Survey on Section 35 T 4 R 13 E. of the 4 P. M. in MILTON Township

Rock County, Wisconsin, made AUGUST the 18<sup>th</sup> 1975


I hereby certify that the following is a correct record of said survey as made by me.

**MICROFILMED**



County Surveyor.

Dug 2.5' Below Road Surface  
Found Limestone Monument.

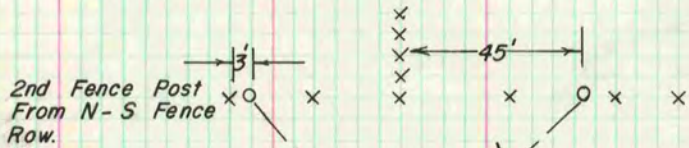

Sec. 35, S 1/4 Cor.

COUNTY LINE ROAD

PAB  
OCT 6, 1975 SET 18" BERNTSEN  
W-I-B MONUMENT

62.98'

Telephone Marker

PRIVATE  
DRIVE

ACCESSORIES TO CORNER  
ARE 1" X 2' PIPES.

