

PLAT AND RECORD

Of a Survey on Section 8, 33 T 2 R 11 E. of the 4 P. M. in PLYMOUTH Township
Rock County, Wisconsin, made SEP the 26 1978


I hereby certify that the following is a correct record of said survey as made by me.

COUNTY BUILDING
CITY OF JANESVILLE



S 1/4 COR SEC 8

2' DEEP FOUND CUT LIMESTONE LAYING ON ITS SIDE, AREA HAD BEEN BULLDOZED.

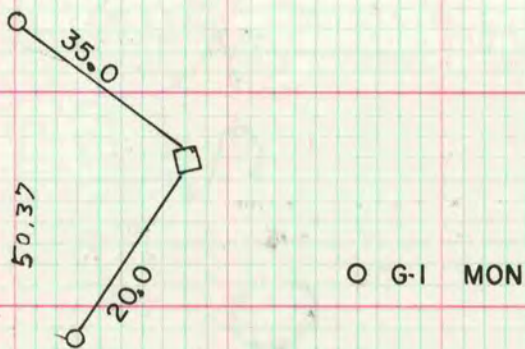

MICROFILMED

W 1/4 COR OF SEC. 33

FD 3.5' DEEP 6 1/2" X 6 1/2" CUT LIMESTONE 1 1/2" THICK, SET ALUM. MON. 15 DEEP
O-11/4" X 24" I.P. 1.5' DEEP

