

40
V-5

VOL. 5 PLAT AND RECORD

COUNTY BUILDING
CITY OF JANESVILLE

COUNTY BUILDING
CITY OF JANESVILLE


Of a Survey on Section 31 T. 3 N. R. 11 E. of the 4 P. M. in CENTER Township

Rock County, Wisconsin, made JUNE the 24th 1974

I hereby certify that the following is a correct record of said survey as made by me.

MICROFILMED

Hugh J. Lee
County Surveyor.

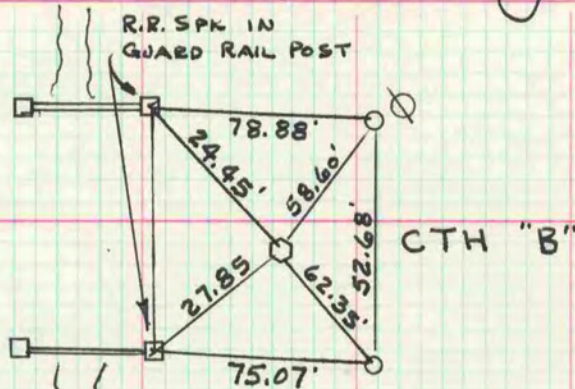

6-24-74 SET ALUM. MON
N. 1/4 COR. BK 170/101
ML RL