

# PLAT AND RECORD

COUNTY BUILDING  
CITY OF JANESVILLE

Of a Survey on Section 25-26-27 T 2N R 12 E. of the 4 P. M. in ROCK Township

Rock County, Wisconsin, made JUNE the 19 67


I hereby certify that the following is a correct record of said survey as made by me.

**MICROFILMED**

*Robt. B. ...*

County Surveyor.

THE GEO. S. BARBAR COMPANY, ST. LOUIS

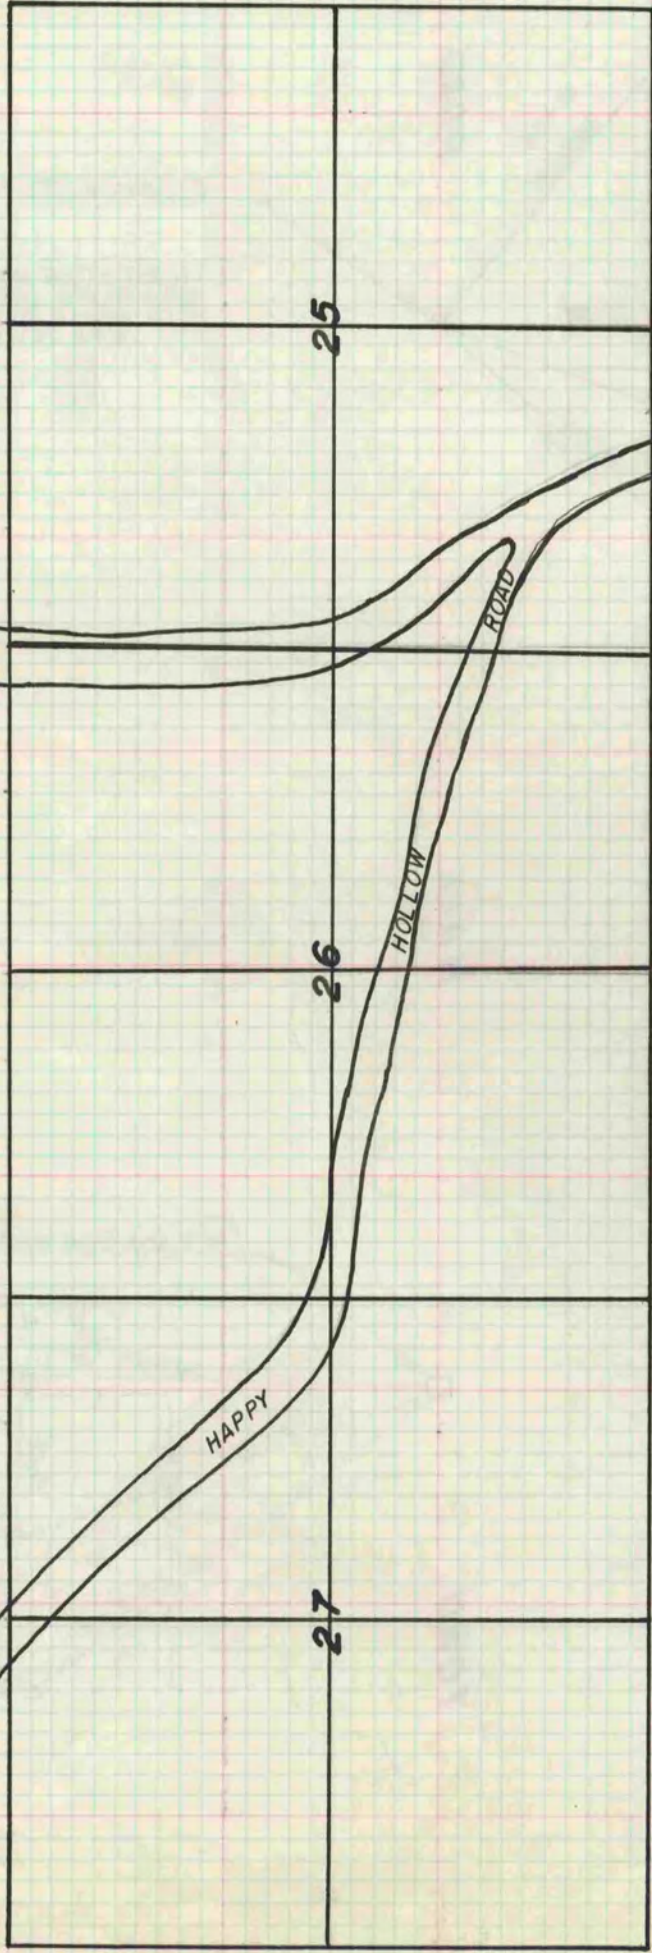

SEE VOL 5 PG 519

HAPPY HOLLOW ROAD  
REFER TO MONUMENT RECORD IN CABINET UNDER "R".  
PLAT REF. TO ORD #8956.  
PLAT REF. TO BAXTER VALLEY ADD.