

PLAT AND RECORD

491

VOL. 5

Of a Survey on Section 21 T. I R. II E. of the 4 P. M. in NEWARK Township
Rock County, Wisconsin, made SEP the 19 78

I hereby certify that the following is a correct record of said survey as made by me.

COUNTY BUILDING
CITY OF JANESVILLE


Ronald Barnes



County Surveyor.


S 1/4 COR. SEC 21 T1N, R11E

FD CUT LIMESTONE 0.3' ABOVE GROUND

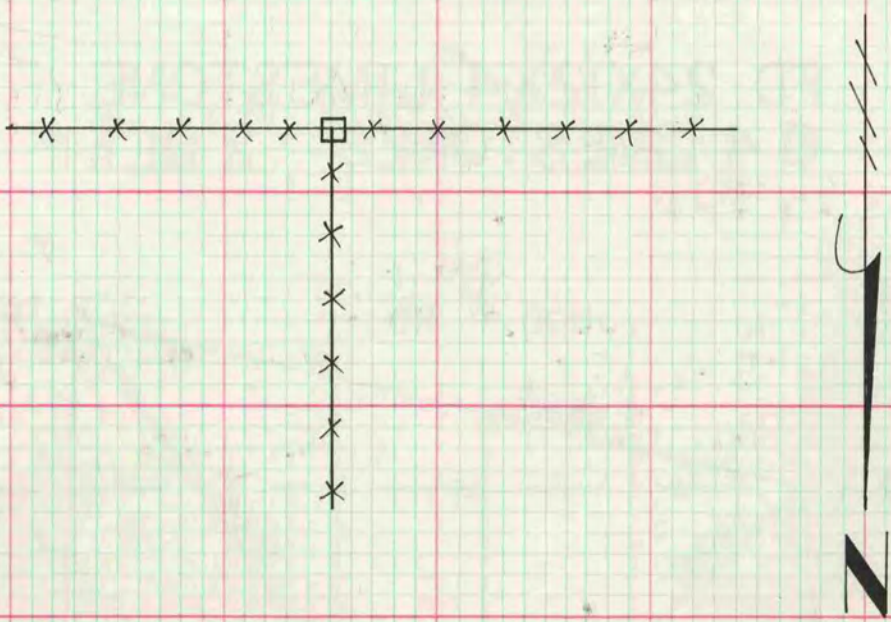

W 1/4 COR SEC 21 T1N R11E

FD CUT LIMESTONE

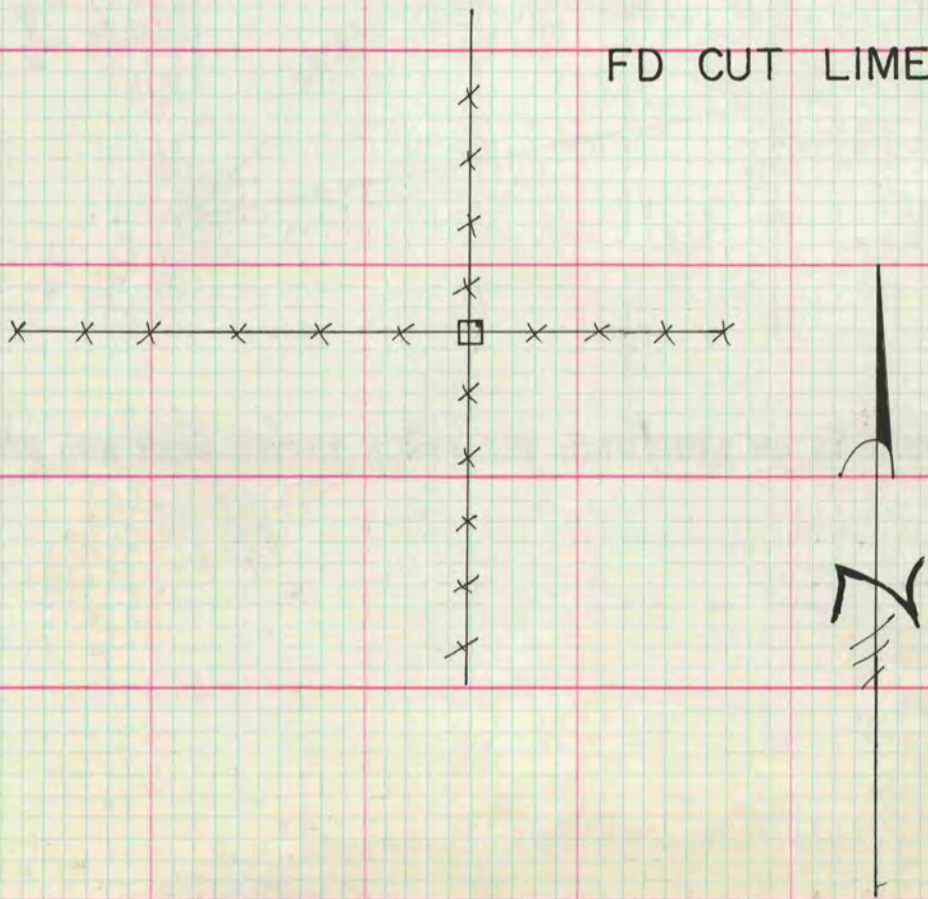

MICROFILMED