

VOL. 5 PLAT AND RECORD

COUNTY BUILDING
CITY OF JANESVILLE

Of a Survey on Section 23 T 4 N R 14 E. of the 4 P. M. in Lima Township

Rock County, Wisconsin, made NOVEMBER 26 19 75

I hereby certify that the following is a correct record of said survey as made by me.

Donald Barnes

DONALD A. BARNES
S-1216
JANESVILLE
WI.

County Surveyor.

MICROFILMED

S $\frac{1}{4}$ COR

SW COR

2653.70' (COMPUTED)
2649.9' REC (ORIGINAL GOV SUR)

DUG LARGE HOLE FOUND FENCE LINE. FOUND 1 HH, 1.5' FROM IT FOUND STAKE IN HORIZONTAL POSITION. AGREED WITH LINES OF OCCUPATION

CAPPED PIPE MARKED ROCK COUNTY

72.54'

N2W

S $\frac{1}{4}$ COR

46.00'


S2E

SET BERNTSEN W-I-B MONUMENT

CAPPED PIPE MARKED ROCK COUNTY

286'

PIONEER RD. (ASPHALT SURFACE)

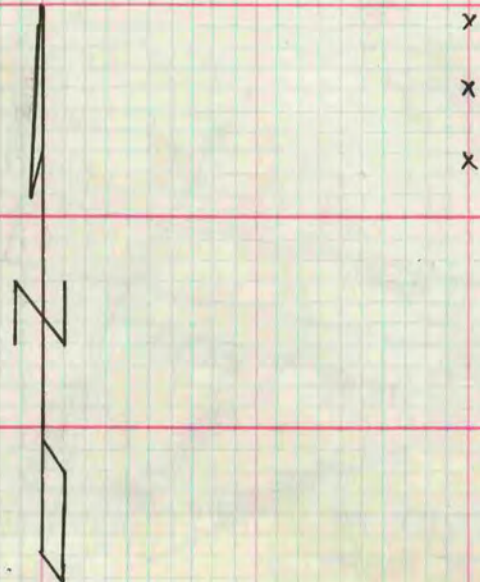

x
x
x