

VOL. 5 PLAT AND RECORD

COUNTY BUILDING
CITY OF JANESVILLE

Of a Survey on Section 31 T 1 R 13 E. of the 4 P. M. in TURTLE Township

Rock County, Wisconsin, made the 19 74


I hereby certify that the following is a correct record of said survey as made by me.

MICROFILMED

County Surveyor. *AS*

DUGÉ FD. NOTHING. SET
COR. BY PRORATION

9-18-74 M.L.
W.K.
J.L.

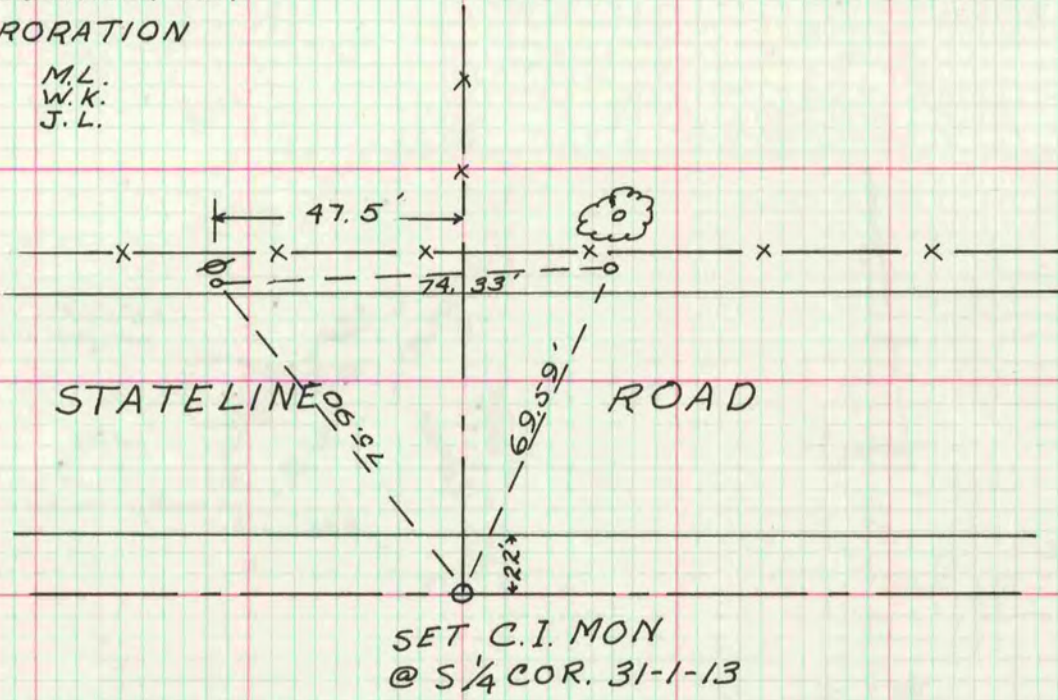

SET C.I. MON
@ S 1/4 COR. 31-1-13