

# PLAT AND RECORD

507

V-4

COUNTY BUILDING  
CITY OF JANESVILLE

COUNTY BUILDING  
CITY OF JANESVILLE

Of a Survey on Section 15 T 4N R 14 E. of the 4 P. M. in LIMA Township

Rock County, Wisconsin, made JUNE the 15 1971

I hereby certify that the following is a correct record of said survey as made by me.


MICROFILMED

*Hugh J. Lee*

County Surveyor.

THE GEO. B. BARNARD COMPANY, ST. LOUIS

NOTE: O = 1" x 24" IRON PIPE REF. MON.

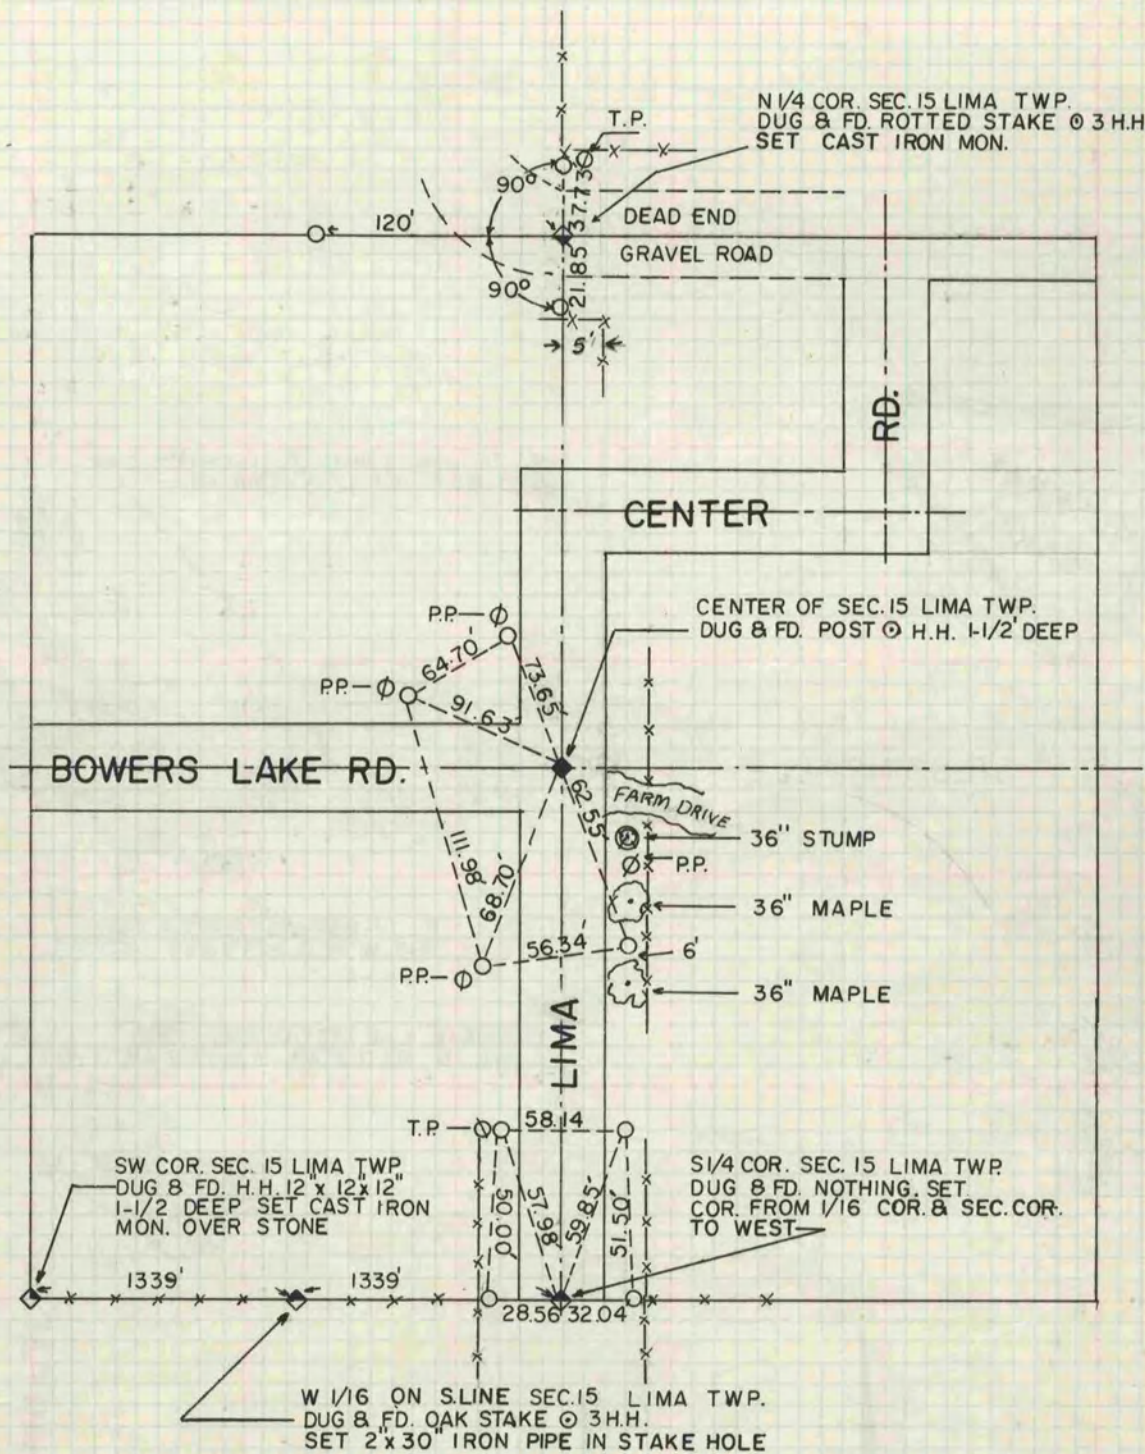

6/15-17/71

JMS  
JEL

