

COUNTY BUILDING
CITY OF JANESVILLE

PLAT AND RECORD

395
V-4

COUNTY BUILDING
CITY OF JANESVILLE

Of a Survey on Section **22** T **1 N** R **13** E. of the 4 P. M. in **TURTLE LE** Township

Rock County, Wisconsin, made **OCTOBER** the **18** 19**68**

I hereby certify that the following is a correct record of said survey as made by me.


COUNTY BUILDING
CITY OF JANESVILLE

MICROFILMED

R. B. St. George

County Surveyor.

NOTE: ALL REFERENCES 1" PIPES

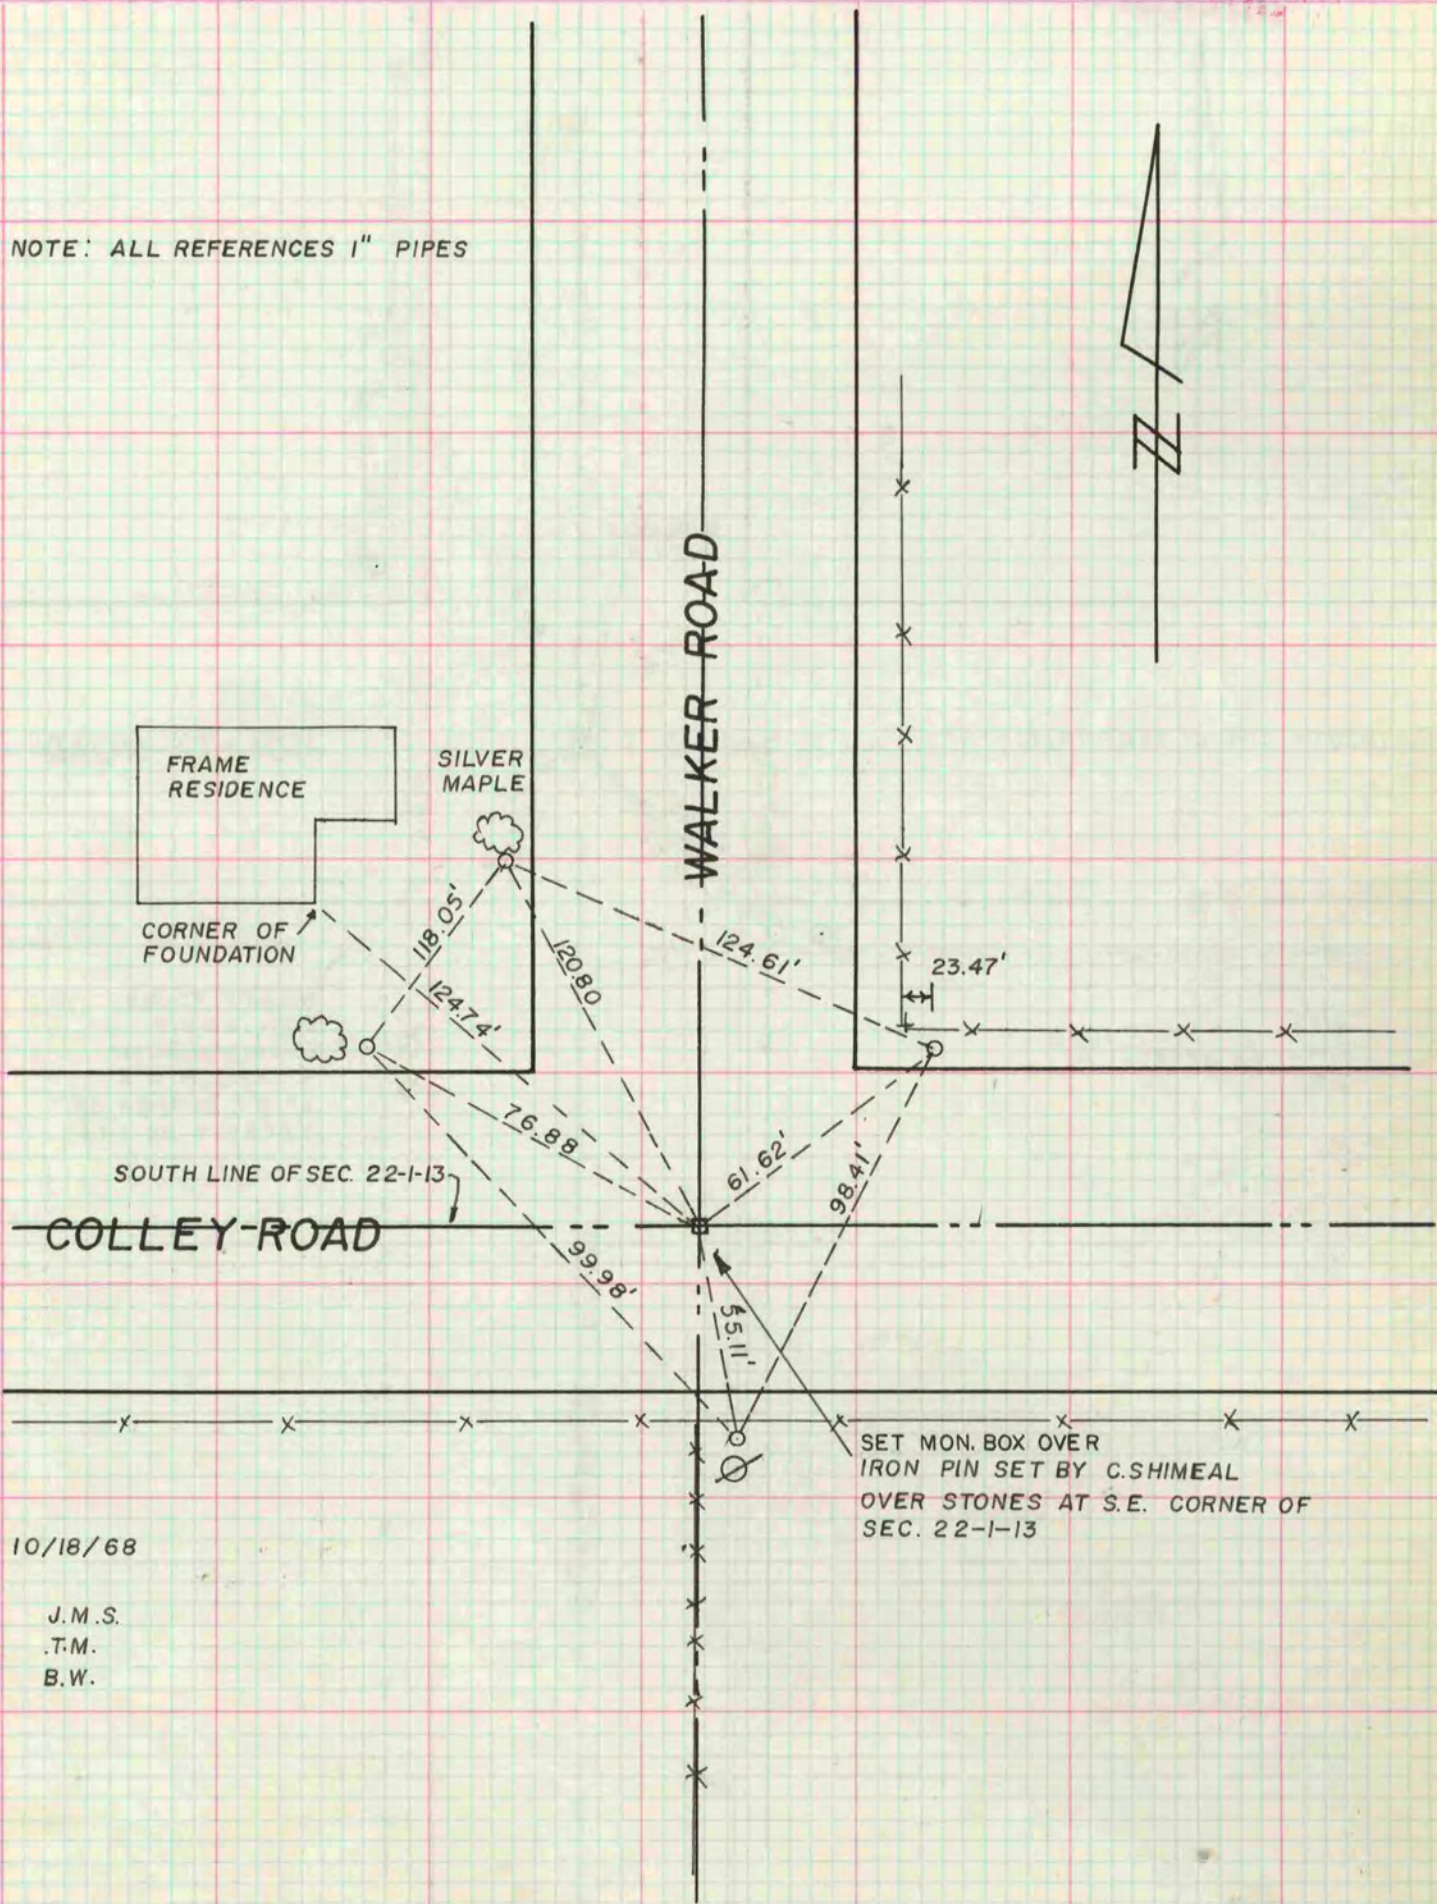

10/18/68

J.M.S.
.T.M.
B.W.