


PLAT AND RECORD

VOL. 6

Of a Survey on Section **21** T. **3** R. **12** E. of the 4 P. M. in **JANESVILLE** Township
Rock County, Wisconsin, made **MARCH** the _____

I hereby certify that the following is a correct record of said survey as made by me.

COUNTY BUILDING
CITY OF JANESVILLE

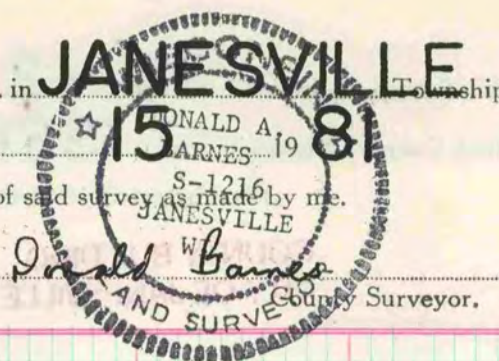


E 1/4 COR SEC 21

REPLACED 1" X 6" IP WITH ALUM MON.

SE COR SEC 21.

REPLACED 1" IP WITH ALUM MON

MICROFILMED

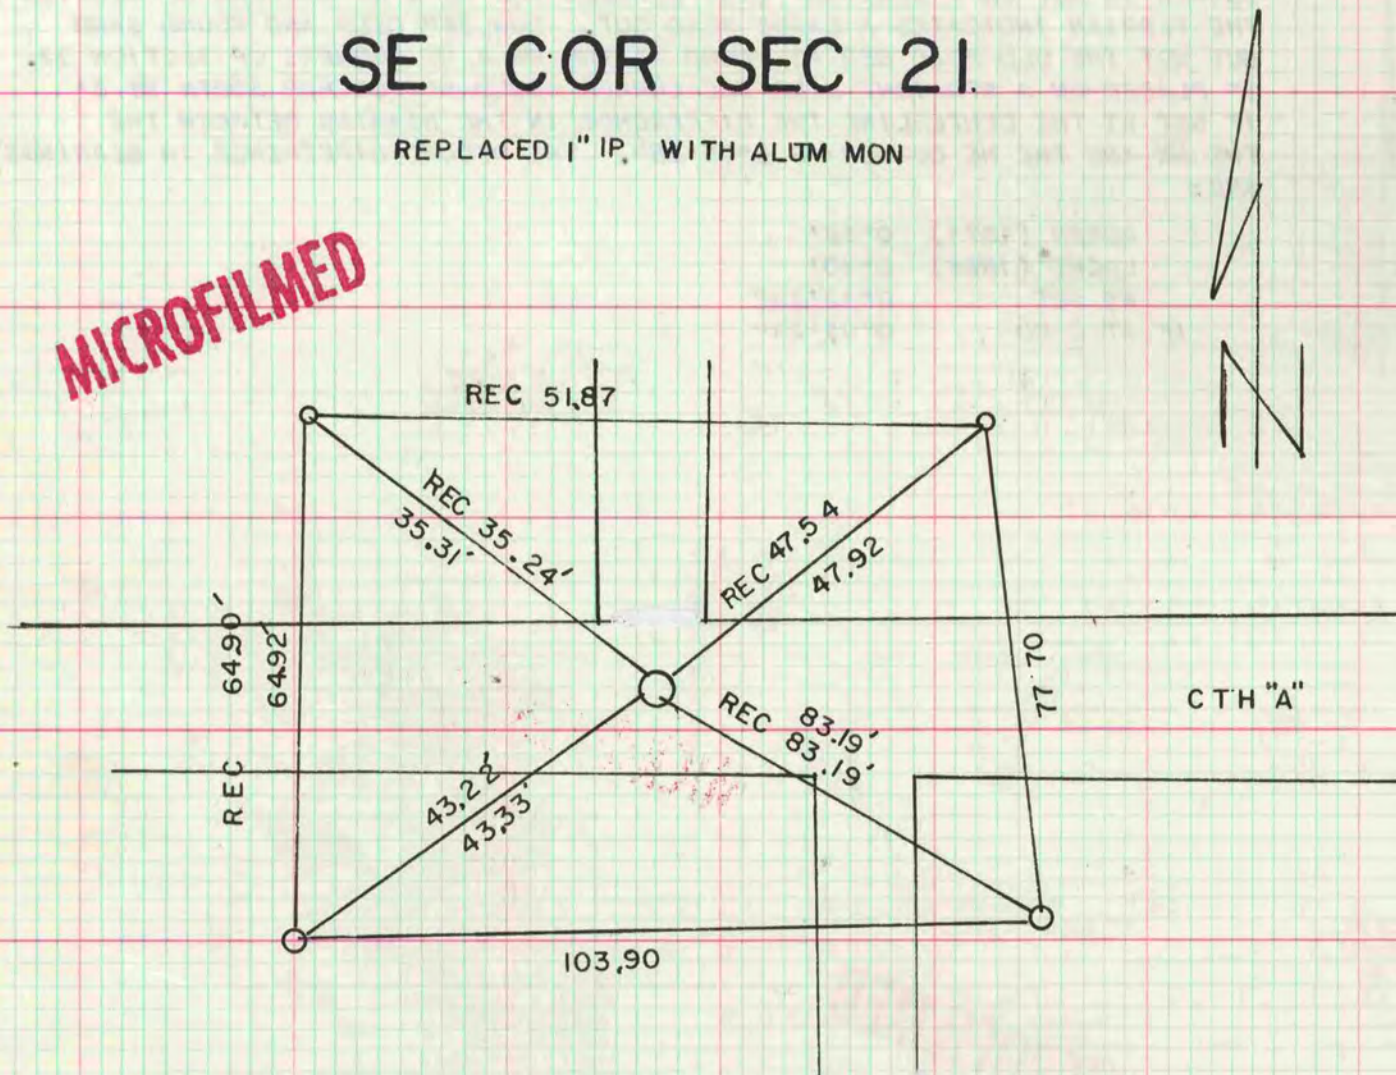

S 1/4 COR SEC 21

REPLACED 1" IP WITH ALUM MON

