

Of a Survey on Section 21 T 4 R 11 E. of the 4 P. M. in PORTER Township  
Rock County, Wisconsin, made APRIL 8 1980

I hereby certify that the following is a correct record of said survey as made by me.

COUNTY BUILDING  
CITY OF JANESVILLE




County Surveyor.

N 1/4 COR SEC 21

AREA WAS FILLED BY EROSION, FOUND STONE OF RECORD  
2.5' DEEP SET ALUM. MON. ON TOP OF STONE.

MICROFILMED

RECORDED

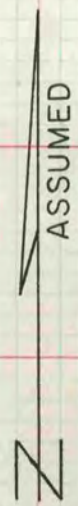

N 1/16 OF THE NE 1/4 SEC 21  
FOUND HARD HEAD 21" x 8" x 3" IN HORIZONTAL POSITION NORTH  
OF THE REMAINS OF OLD POST. SET 3/8" x 32" IRON BOLT

