

PLAT AND RECORD

93

VOL. 6

Of a Survey on Section **34,35** T. **1** R. **14** E. of the 4 P. M. in **CLINTON** Township

Rock County, Wisconsin, made **NOV** the **24th** 19**80**

I hereby certify that the following is a correct copy of the original as made by me.

COUNTY BUILDING
CITY OF JANESVILLE




County Surveyor.

E1/4 COR SEC 35

DUG & FOUND YELLOW BRICK ON LINE WITH SE & NE CORNERS OF SECTION 35 AT SINGLE PROPORTIONATE DISTANCE. REPLACED WITH ALUM MON NORTH & WEST FENCE LINE IS NEW. OLD WAS BULLDOZED OUT.

MICROFILMED

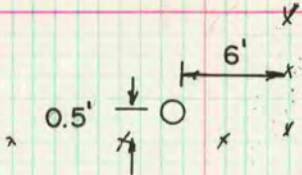

W1/4 COR SEC 34

DUG & FOUND LARGE RED HARDHEAD 7"X7"X14" WITH POINT UP. REPLACED WITH ALUM MON



E1/4 COR SEC 34

DUG & FOUND NOTHING. SET ALUM MON ON LINE WITH NE & SE CORNERS OF SECTION 34 AT SINGLE PROPORTIONATE DISTANCE

