

PLAT AND RECORD

173

VOL. 6


Of a Survey on Section 3 T 3 R 14 E. of the 4 P. M. in JOHNSTOWN Township
Rock County, Wisconsin, made MAY the 27 1981

I hereby certify that the following is a correct record of said survey as made by me.

COUNTY BUILDING
CITY OF JANESVILLE

County Surveyor.

NW COR. SEC. 3 T3N R14E

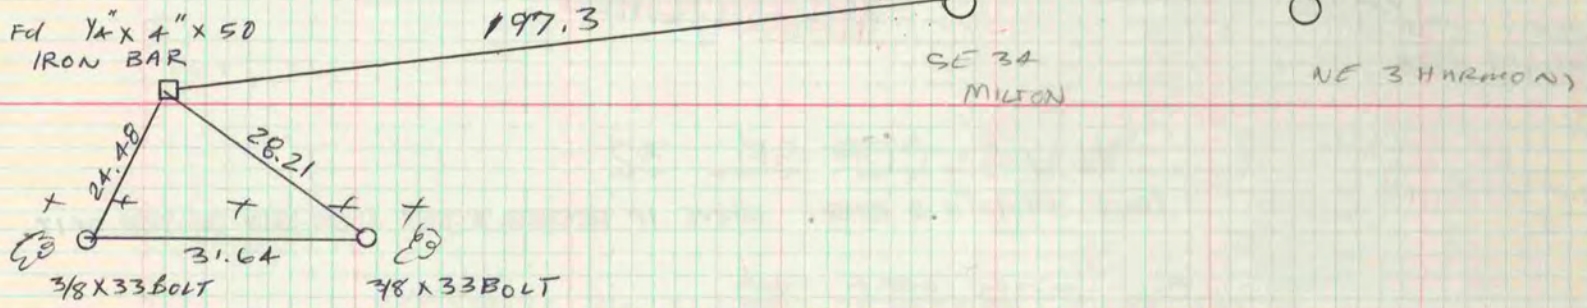

MICROFILMED