

Of a Survey on Section 2, 4 T 2 R 14 E. of the 4 P. M. in BRADFORD Township

Rock County, Wisconsin, made MAY the 1 19 80


I hereby certify that the following is a correct and true survey as made by me.



County Surveyor.

S 1/4 COR SEC 2


DUG 2.5' DEEP & FOUND OLD GRAVEL ROAD BED DUG 2' DEEPER AND FOUND NOTHING. SET 1" IRON PIPE OR NAIL WITH SE & SW COR SEC 2 AT SINGLE PROPORTIONATE DISTANCE. 1" IRON PIPE IS NORTH OF C ± 2'.

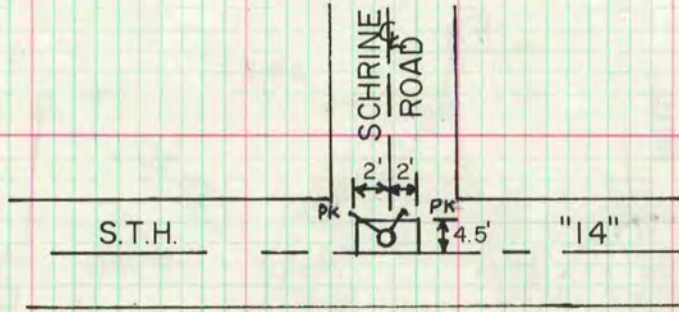

MICROFILMED

S 1/4 COR SEC 4

DUG 2.5' DEEP & FOUND WOOD STAKE. TERRAIN AND SOILS INDICATE ROAD WAS CUT AND HARD HEAD RUGER SET ON TOP OF STAKE WAS DESTROYED.

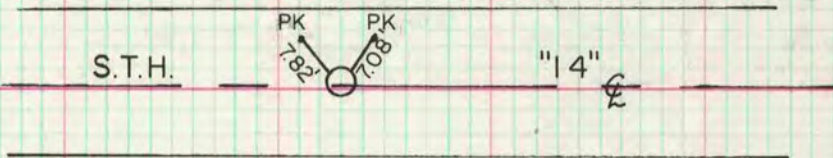

ASSUMED
N

E 1/4 COR SEC 2

FOUND BROKEN LIMESTONE 15"x8"x4" IN VERTICAL POSITION. 2.5' DEEP FOUND 4"x4"x8" LONG CUT LIMESTONE, SET ALUM. MON.

