

PLAT AND RECORD

Of a Survey on Section **31, 30 T 3 R 14** E. of the 4 P. M. in **JOHNSTOWN** Township

Rock County, Wisconsin, made **JULY** the _____


I hereby certify that the following is a correct record of said survey as made by me.



COUNTY BUILDING CITY OF JANESVILLE

NW COR SEC 31

FD. PK NAIL IN ROAD - BENT. FD. WHAT APPEARED TO BE CUT LIMESTONE UNDER PK. SET ALUM MON

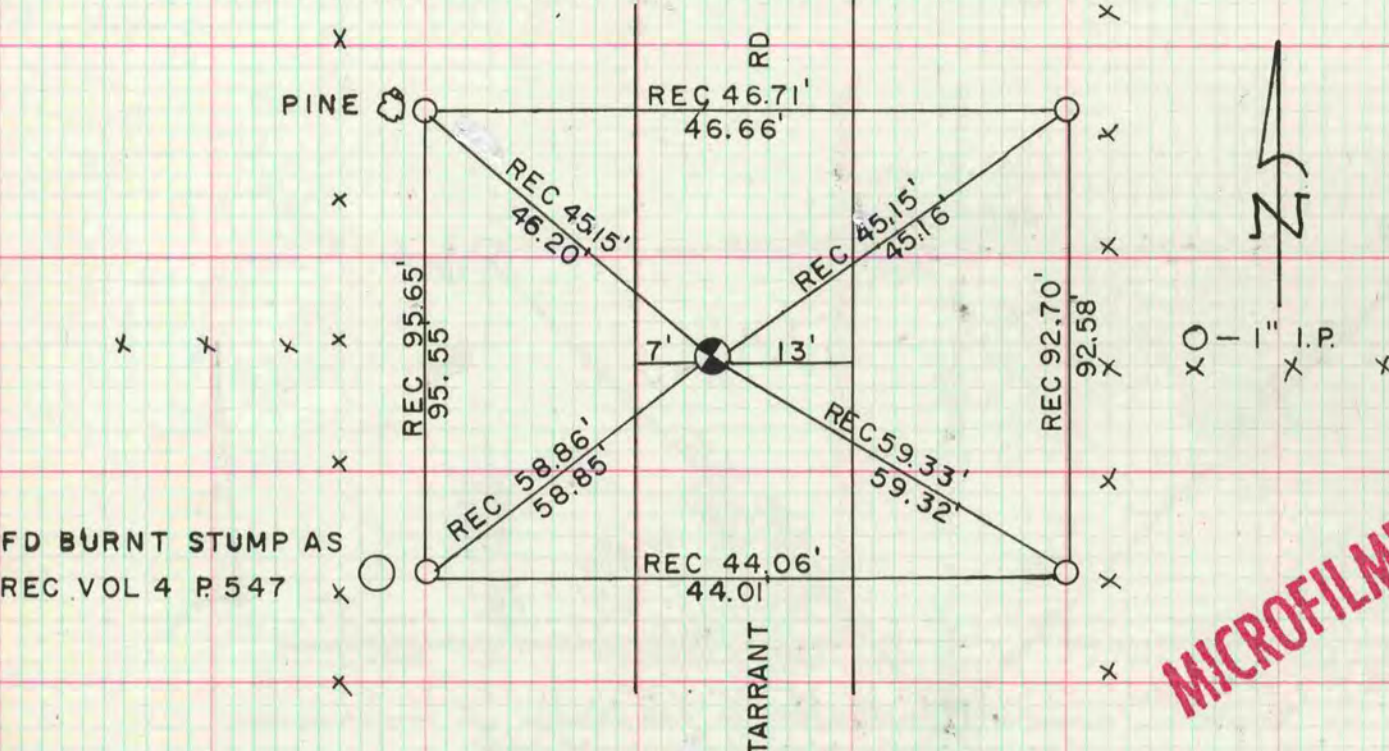

MICROFILMED

W 1/4 COR. SEC. 30

FOUND LIMESTONE MON. IN GOOD REPAIR DOWN 1.4', DREW DIAGONALS, DRILLED HOLE AND CEMENTED ADJUSTABLE ALUM. MON. (SPIKE) IN HOLE.

