

PLAT AND RECORD

VOL. 6

26

T 1 R 10

CLINTON

Of a Survey on Section 2 E. of the 4 P. M. in AVON Township

Rock County, Wisconsin, made the 19


I hereby certify that the following is a correct record of said survey as made by me.

COUNTY BUILDING
CITY OF JANESVILLE



S 1/4 COR SEC 2 AVON

DUG 1.5' DEEP HOLE & FOUND NOTHING. SET ALUM MON ON LINE WITH THE SE COR & THE S1/16th COR OF THE SE 1/4 OF SEC 2 AT THE MEAN REC DISTANCE OF LOCKE & LEE.

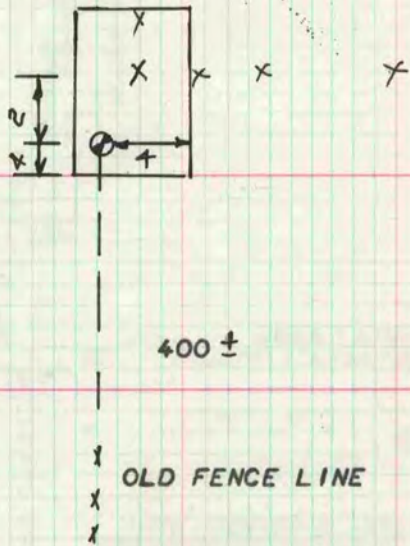

MICROFILMED

S 1/4 COR SEC 26 CLINTON

DUG & FOUND 3' DEEP 4HH & REMAINS OF PARTS OF A STAKE.

