

PLAT AND RECORD


163

VOL. 6

Of a Survey on Section **27** T **4** R **10** E. of the 4 P. M. in **UNION** Township
Rock County, Wisconsin, made **APRIL 23** 19**81**

I hereby certify that the following is a correct record of said survey as made by me.


COUNTY BUILDING
CITY OF JANESVILLE

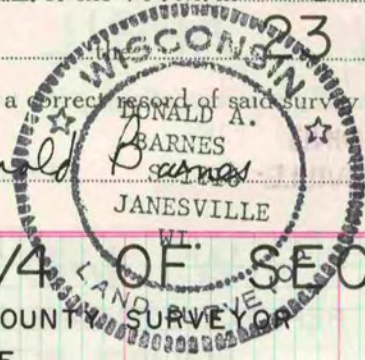


County Surveyor.

UNKNOWN COR SE 1/4 OF SEC 27

DATA SUPPLIED BY WALWORTH COUNTY SURVEYOR
EVANSVILLE

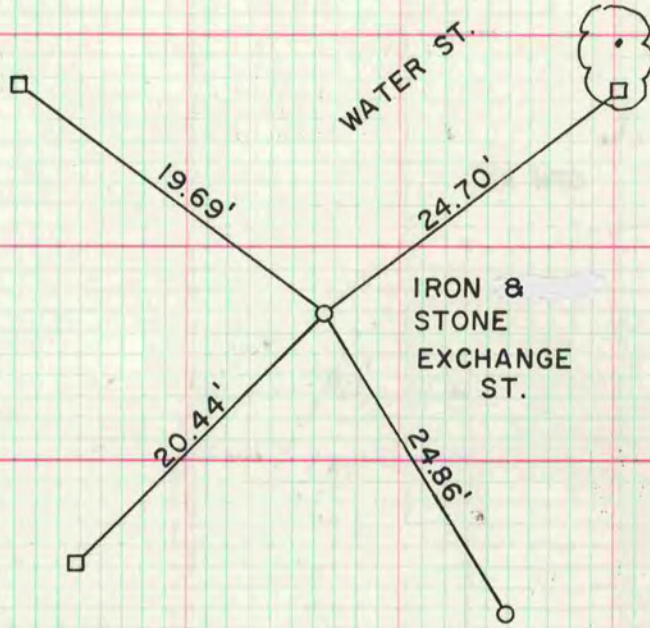

IRON ON INT. OF
WATER & EXCHANGE

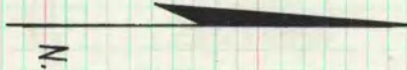

MICROFILMED