

VOL. 6 PLAT AND RECORD

36

Of a Survey on Section 1, 2 T 2 R 14 E. of the 4 P. M. in BRAFORD Township
Rock County, Wisconsin, made APRIL the 30 1930

I hereby certify that the following is a correct record of said survey as made by


COUNTY BUILDING
CITY OF JANESVILLE

Donald B. Barnes



SE COR SEC

DUG 3' DEEP & FOUND NOTHING. SET 1" IRON PIPE AT OCCUPATION LINES. THIS IS IN HARMONY WITH RUGER'S NOTES DATED MARCH 30, 1861, AND THE ORIG. GOV. NOTES. SOILS & TERRAIN INDICATE A ROAD CUT.

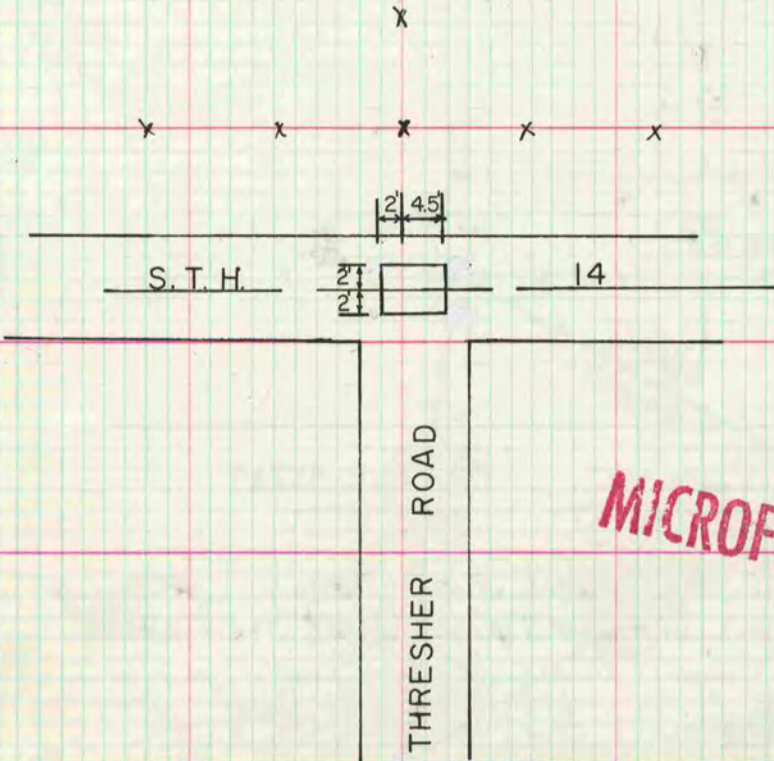

MICROFILMED

S 1/4 COR SEC 1

DUG & FOUND NOTHING. SET 1" IRON PIPE AT SINGLE PROPORTIONATE DISTANCE ON LINE WITH SE & SW COR SEC 1. SOILS & TERRAIN INDICATE A ROAD CUT

