
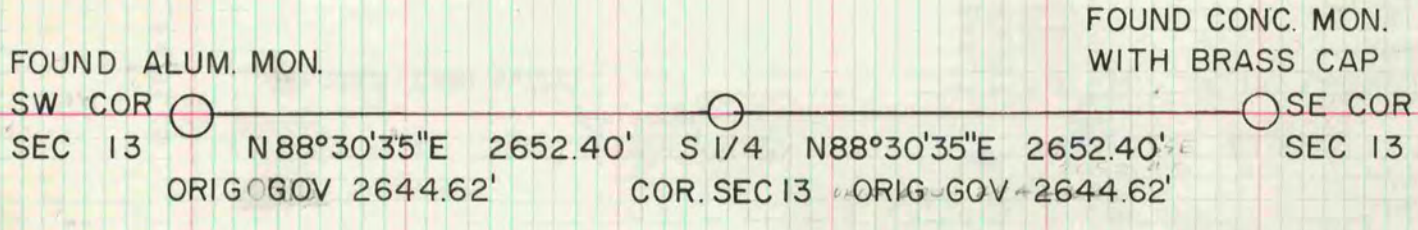


576 VOL. 6 PLAT AND RECORD
30

Of a Survey on Section **13** T. **1** R. **14** E. of the 4 P. M. in **CLINTON** Township
 Rock County, Wisconsin, made **MAY** the **1980**

I hereby certify that the following is a correct record of said survey as made by me.
COUNTY BUILDING
CITY OF JANESVILLE

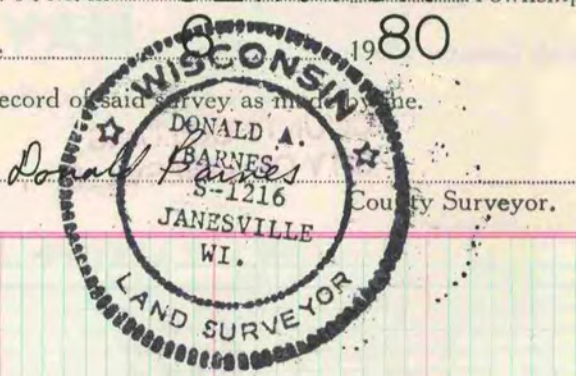

MICROFILMED

ASSUMED
 N

S 1/4 COR SEC 13

B.J. SUNNY DUG AND FOUND NOTHING, VOL 3, PAGE 458. SET ALUM. MON.
 ON LINE WITH SE & SW CORNERS OF SEC 13 AT SINGLE PROPORTIONATE
 DISTANCE.

