

Of a Survey on Section 6 T 2 R 10 E. of the 4 P. M. in Spring Valley Township
 Rock County, Wisconsin, made May the 11th 1855

I hereby certify that the following is a correct record of said survey as made by me.

(Signed) Joseph Church
 R. H. B. County Surveyor.

COUNTY BUILDING
 CITY OF JANESVILLE

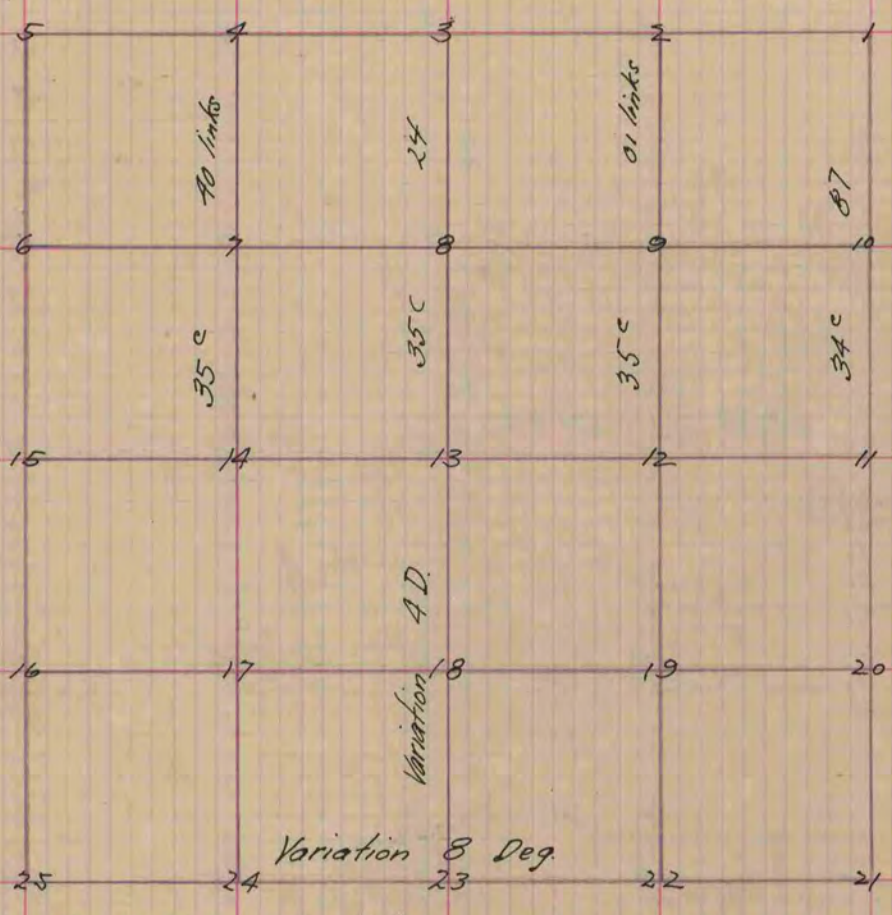


Fig 13 Bur O. S. 11 E 85 links
 " " " " N 49 W 109 "
 " 12 Black O S 86 E 203 "
 Bur. O. N 53 E 156 "
 " 14 " " N 58 E 47 "
 " " S 65 W. 21 " the above notes were taken with
 variation of 4 D on the Compass
 " 3 Bur O. S. 28 E 191 links
 " " S 15 W 195 "
 " 2 " " S 9 E 225 "
 " " S. 45 W. 248 " the last were taken with 7/2

Copied from P. 37 Vol. 1. County Surveyors Record