


# PLAT AND RECORD

COUNTY BUILDING  
CITY OF JANESVILLE


Of a Survey on Section **16** T **3 N** R **12** E. of the 4 P. M. in **JANESVILLE** Township  
Rock County, Wisconsin, made **APRIL** the **8** 1970

I hereby certify that the following is a correct record of said survey as made by me.

**MICROFILMED**

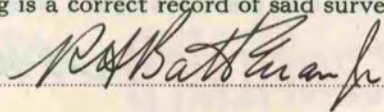

County Surveyor.

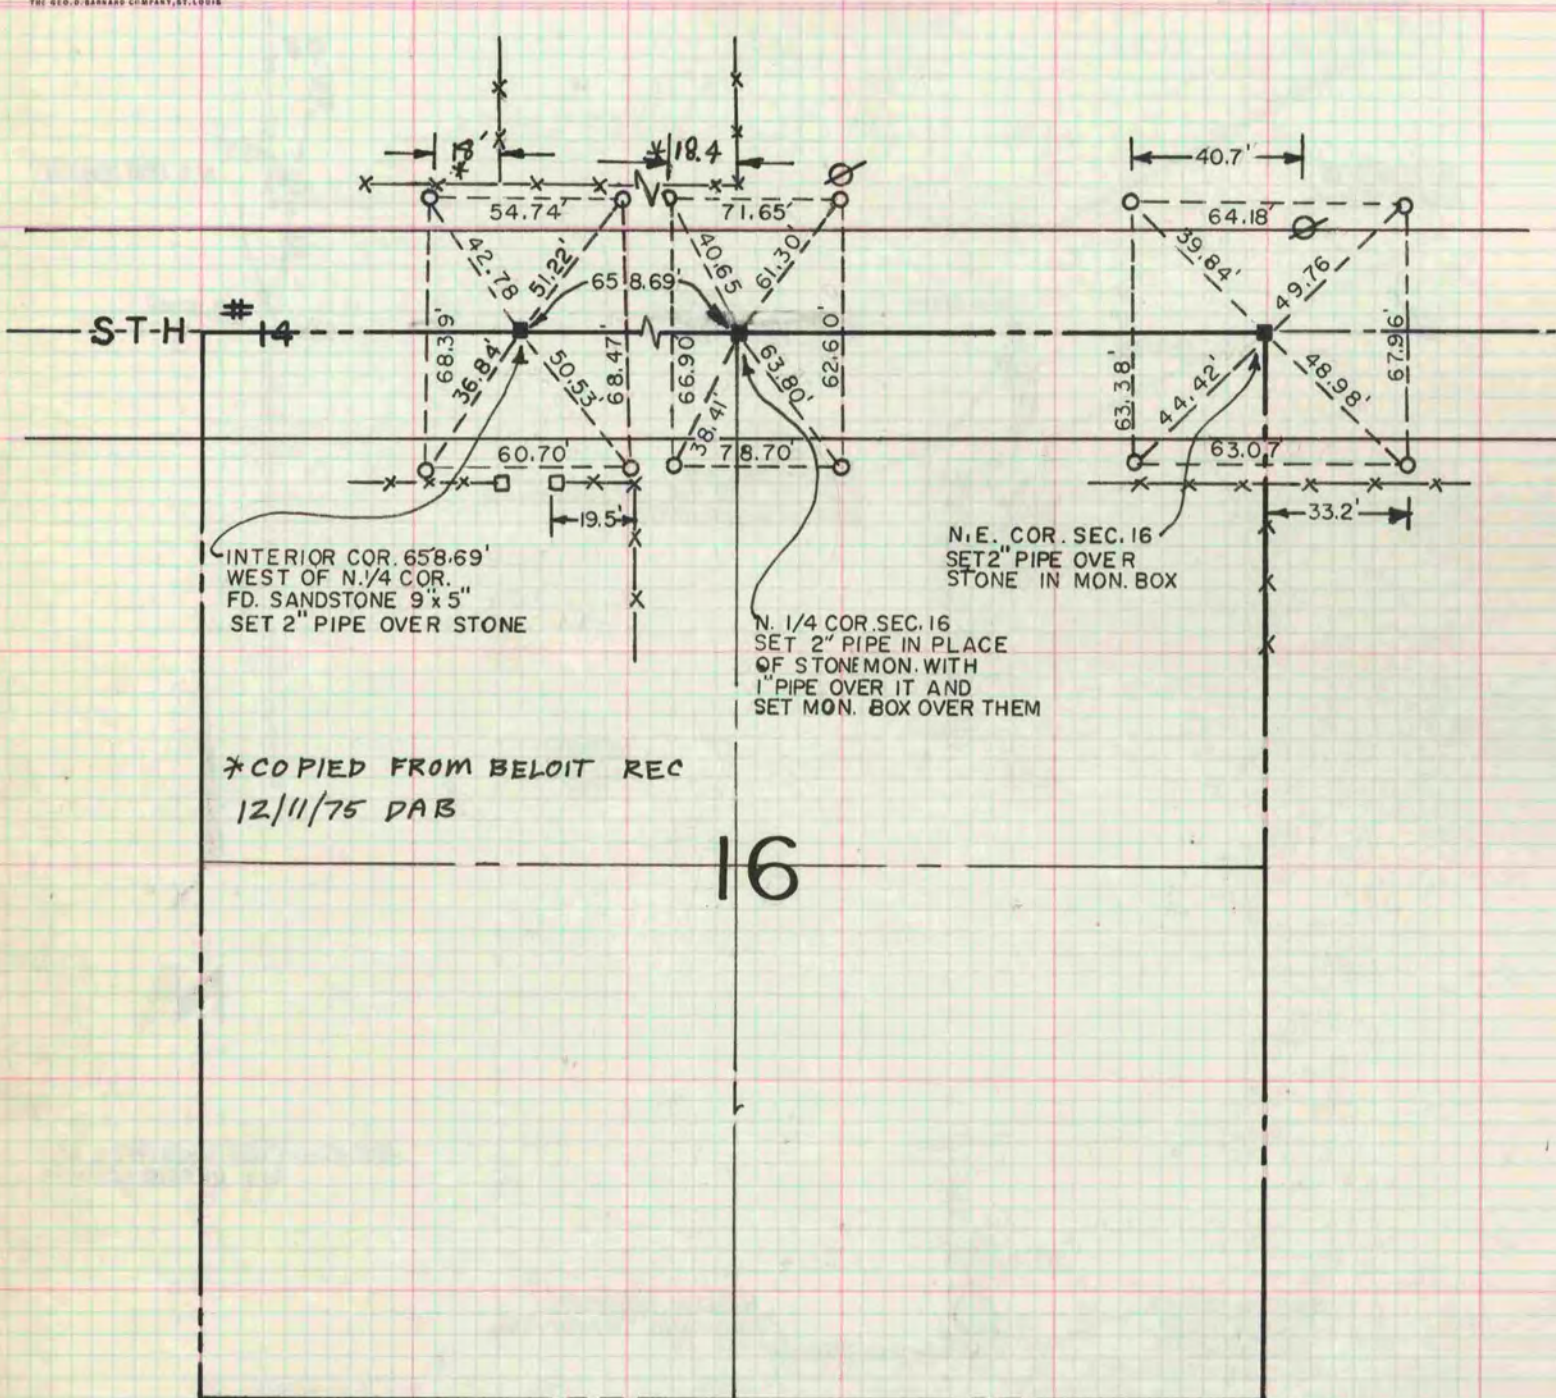

\* COPIED FROM БЕЛОIT REC  
12/11/75 DAB

## 16



APRIL 8, 1970  
R.B.  
T.M.  
G.B.

NOTE:  $\circ$  = 1" x 24" IRON PIPE AT ALL REF. PTS.